18

ADAMS COUNTY COUNTY CORNER NO: 51 ROMPORTOL ID: 41807110000

PUBLIC LAND SURVEY MONUMENT RECORD

RAILROAD SPIKE TYPE OF MONUMENT:

ADAMS COUNTY COORDINATES, NAD 83 (2007)

N. 245667.523

E. 583368.959

DATUM - -----ELEVATION-

FIELD WORK DATE: 02/04/2020


BASIS FOR MONUMENT LOCATION

1973 - PLS 878 SET HARRISON MONUMENT BY TRAVERSE OF THE ENTIRE SECTION, COMPARING POSSESSION LINES AND ORIGINAL NOTES. DID NOT DIG BECAUSE OF DEEP FILL IN ROAD.

2020 - PLS 2675 FOUND MAGNAIL IN THE ROAD SURFACE, REMOVED, FOUND RAILROAD SPIKE 10" BELOW, AND 1 WITNESS. REMOVED RAILROAD SPIKE AND FOUND NO OTHER EVIDENCE OF ANY ADDITIONAL MONUMENT BELOW. THE RAILROAD SPIKE LOCATION AGREES WITH THE EXISTING WITNESS. ACCEPTED THE RAILROAD SPIKE AS THE CORNER LOCATION. RE-SET THE RAILROAD SPIKE IN THE FOUND LOCATION, SET 3 NEW TIES, MEASURED TO A FOUND PROPERTY IRON AND THE WITNESS.



(INDICATE CORNER BY "X")

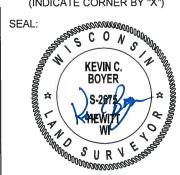

DATA SHOWN HERE ON THIS TIE SHEET IS CORRECT AND COMPLETE TO THE BEST OF MY KNOWLEDGE AND BELIEF.


PROFESSIONAL LAND SURVEYOR

-TIE SKETCH

NOTE: THE CORNER LANDS 0.5'± WEST OF CENTERLINE OF CTH "G".



- SET 3/4" x 18" IRON REBAR, 1.50#/FT
- O FOUND 1-1/4" O.D. IRON PIPE
- FOUND RAILROAD SPIKE
- STEEL FENCE POST
- → VINYL "T" POST

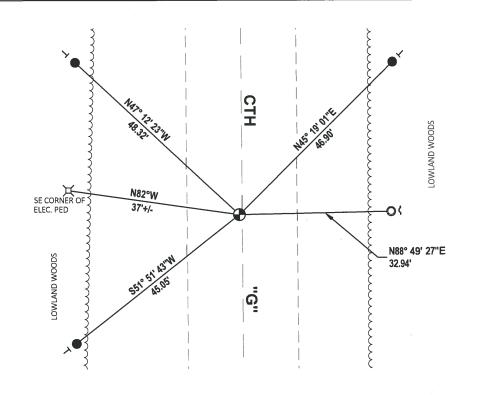

CORNER NO. __26? ADAMS COUNTY SECTION Survey Monument Record TYPE OF MONUMENT: Harrison std. TOWN RANGE STATE PLANE COORDINATES: N. ELEVATION - M.S.L. DATUM: _ THETA ANGLE: . FIELD BOOK: ___ BASIS FOR MONUMENT LOCATION (Use reverse side if necessary) Show info such as: History of corner, with reference to Vol. and pg, dates, surveyor; exact description of monument replaced; if location computed, by taped or EDM traverse; landowner SEAL: remarks, etc. Set by traverse of the entire section, comparing possession lines and original notes. Did not dig because of deep fill in road. 6 R. 55 3-28-77 CORNER 0.5, PK-55 5-17-82 ڪ ڪ 2. 23-87 KZ-55 11-26-91 CERTIFIED CORRECT: JG-55 2-18-97 JG (FO MAG NAIL AT CURVER) 1-21-02 Registered Land DATE: 4 4-06-07 - CPR TIE SKETCH (Show at least four ties) Ties to nail and disc. 55.281 De Poppet 40.55. E5 6"ELM/87

CULUERT

REVISED 1972