## ADAMS COUNTY COUNTY CORNER NO: 56 ROMPORTOL ID: 41807172000

### PUBLIC LAND SURVEY MONUMENT RECORD

TYPE OF MONUMENT:	HARRISON	
ADAMS COUNTY COORD	DINATES, NAD 83 (2007)	
N. <b>242913</b> .	584	
E 567450.	323	

ELEVATION-DATUM

FIELD WORK DATE: 01/10/2020

#### BASIS FOR MONUMENT LOCATION

1977 - PLS 1245 RAN EDM TRAVERSE AROUND SECTION 16 AND TIED IN ALL EXISTING EVIDENCE. SET WEST1/4 CORNER ON STRAIGHT LINE IN PROPORTION TO ORIGINAL TIES.


1978 - PLS 1184 USING EDM TRAVERSE BEGINNING AT THE SE AND SW CORNERS OF SECTION 16, SET BY A. KIEDROWSKI, AND FOLLOWING THE ORIGINAL SECTION MEASUREMENTS, AS RECORDED IN VOL. 8, PG. 18 AND VOL.3, PG. 6 OF 1901 AND 1925 SURVEY NOTES LOCATED THE WEST1/4 POST OF SECTION 17 AND SET A MONUMENT AT THE BASE OF POST. THEN CALCULATED THE LOCATION OF AND SET THE W1/4 OF SECTION 16.

2011 - PLS 2663 FOUND HARRISON MONUMENT BROKEN AND ON TOP OF GROUND AND ONLY ONE WITNESS MONUMENT. SET HARRISON MONUMENT USING EXISTING WITNESS MONUMENT AND SECTION SUMMARY BY PLS 1551 DATED 6-29-83.

2020 - PLS 2675 FOUND HARRISON MONUMENT FLUSH WITH THE GROUND SURFACE AND 4 TIES. THE MONUMENT AGREES WITH ALL 4 TIES. ACCEPTED THE HARRISON AS THE CORNER LOCATION. MEASURED TO THE EXISTING TIES.



(INDICATE CORNER BY "X")

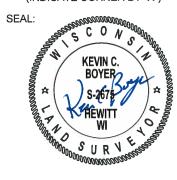

DATA SHOWN HERE ON THIS TIE SHEET IS CORRECT AND COMPLETE TO THE BEST OF MY KNOWLEDGE AND BELIEF.

PROFESSIONAL LAND SURVEYOR

7070

#### -TIE SKETCH

NOTE: THE CORNER LANDS 36'± NORTH OF THE TRAIL.



				٥	þ
			LOWLAND S	SWAMP	
		TO No.	i) 8	nas at Sit	
			36. M	May 69 p	
	(0−	N88° 31' 53"W 44.48'	1	S86° 47' 41 39.81'	!"E ──○⟨
TOP SLOPE					

_	Ct	N:	TEF	RLIN	١Ę١	OF	DI	TCI	Н
						_			-

TRAIL

STEEL FENCE POST

O FOUND 3/4" IRON ROD

FOUND HARRISON MONUMENT

VINYL "T" POST

LOWLAND SWAMP

LOWLAND SWAMP

## U.S. PUBLIC LAND SURVEY MONUMENT RECORD ADAMS COUNTY, WISCONSIN

CORNER NO. 56 CORNER NO. 41807172000

IN ACCORDANCE WITH WISCONSIN ADMINISTRATIVE CODE, CHAPTER A-E 7.08 (3) (A)-(I)

LOCATION: CHAPTER A-E 7.08 (3): (A)

SECTION 17 TOWNSHIP 18 NORTH RANGE 7 EAST

TOWN OF: RICHFIELD


TYPE OF CORNER: EAST QUARTER CORNER

TYPE OF MONUMENT: HARRISON CAST IRON MONUMENT

HORIZONTAL DATUM: NAD 83-91 GRID

ADAMS COUNTY COORDINATES:

NORTHING: 242913.649 EASTING: 567450.325

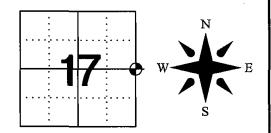


#### RECOVERY PROCEDURES: CHAPTER A-E 7.08 (3): (B), (F), (G), (H)

15 SEPT. 1978 RLS 1184; USING AN E.D.M. TRAVERSE BEGINNING AT THE SE AND SW CORNERS OF SECTION 16, SET BY KIEDROWSKI, AND FOLLOWING THE ORIGINAL SECTION MEASUREMENTS, AS RECORDED IN VOL. 8, PAGE 18 AND VOL. 3, PAGE 6 OF 1901 AND 1925 SURVEY NOTES WE LOCATED THE WEST 1/4 POST OF SECTION 17 AND SET A MONUMENT AT THE BASE OF POST. WE THEN CALCULATED THE LOCATION OF AND SET THE W 1/4 CORNER OF SECTION 16.

10-9-07; JG FOUND EXISTING MONUMENT AND ALL PIPE TIES. ONLY ABOUT 6in. OF HARRISON IS IN THE GROUND

19 JANUARY 2011; FOUND HARRISON MONUMENT BROKEN AND ON TOP OF GROUND AND ONLY ONE WITNESS MONUMENT. SET HARRISON CAST IRON MONUMENT USING EXISTING WITNESS MONUMENT AND SECTION SUMMARY BY RLS 1551 DATED 6-29-83

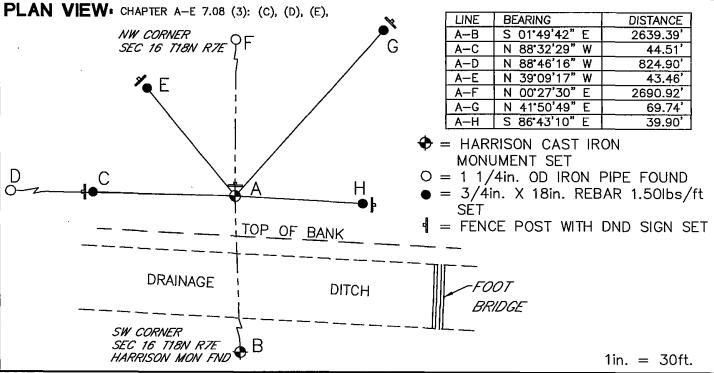

#### SURVEYOR'S CERTIFICATE.

CHAPTER 7.08 (3): (I)

THE UNDERSIGNED HEREBY CERTIFIES THAT THE U.S. PUBLIC LAND SURVEY MONUMENT RECORD IS CORRECT AND COMPLETE TO THE BEST OF MY KNOWLEDGE AND BELIEF.

DARREN B.

KRZANOWSKI X MOSINEE.

WI OUT

DARREN B. KRZANOWSKI

WISCONSIN LÁND SURVEYOR S-2663 DATED THIS 21ST DAY OF JANUARY 2011

	Land Corne	<del></del>				-	•
ADAMS		County			CORNER NO		
	<sub>ENT:</sub> Harrison	County n Std.			SECTION	<u>16</u>	18 N
			_		TOWN	÷	
	<u>E</u>		_		RANGE	R_	_ <del>7</del> _E
ELEVATION — M	I.S.L. DATUM:		_		- <del>1</del>		
			_	ļ			4
		PAGE		<b>!</b>			4
DRAWN BY:				<b>X</b>		h	11
m.1.070 ==== 1				1			N
BASIS FOR MON	NUMENT LOCAT	<u>'ION</u>					
and pg., dates, surv	listory of corner, with eyor; exact description	n of monument		<u> </u>	<u>.ii</u>		
replaced; if location of	computed, by taped of the computed of the comp	r EDM traverse:		(I	LOCATION ndicated by 'X'	')	
		e beginning at	the CE	SEAL:	ndicated by A	,	
and SW corne	ers of Section	on 16. set by		=			
Kiedr <b>ow</b> ski,	and following	ng the original	1	Santa M	SCONS	11/10	
Section meas	urements, as	s recorded in to e 6 of 1901 and	Vol. 8,		part se	1	
survey notes	we located	the West ‡ pos	a 1925 1 st of 1	<b>3</b> /1	ENNIS M.	\ \ \ \ \ \ \ \ \ \ \ \ \ \ \ \ \ \ \ \	
Section 17 a	ind set a moi	nument at the 1	base of	ير =	GREEN s-1184	<b>☆</b>	
post. We th	en calculate corner of Sec	ed the location	n of and	<b>171</b>	MADISON,	C E	
ьео опе и <del>д</del> с	otwer of 260	sition 10.	! !	P	WIS.	/,03	
				30,0	, * * * * * * * * * * * * * * * * * * *		
					SUR	VII	
					WN HERE OF	N	
			•	CERTIFIED	CORRECT:	1 9/400	,
				Registered La	nd Surveyor	X JEW	n_
				DATE:	Sept	15,197	18
				DATE: _ac	0		
TIE SKETCH		1-			) I 1/2	" X 2 4" IRON	PIPE
	es also fanca lines ro	<u>*</u>					
Show at least four tie	is, and fence unes, the	ıds, topo, size	0111111		2,7	ı	
and type of witness t	rees' and if off road	ads, topo, size - best way to	SWAMP		χ \ χ.	1	
and type of witness t	rees' and if off road	ads, topo, size - best way to	SWAMP	¥ ,	χ \ χ.	¥.	
and type of witness t	rees' and if off road	ads, topo, size - best way to	SWAMP	± ,	χ \ χ.		
and type of witness t	rees' and if off road	- best way to		¥ 20,8/	1.8.8. A		
and type of witness t	rees' and if off road	- best way to	SWAMP 87°- 54'W, 82	₹	٦ ما ق	<b>¥</b>	
and type of witness t	rees' and if off road	- best way to	87°- 54'W, 82	₹	¥ N 89°-07'E,	3'19 <sub>1</sub> ,	
Show at least four tie and type of witness t arrive at corner.	rees' and if off road	- best way to  N  O  1 1/2"X 24" IRON	87°- 54'W, 82 N PIPE SET	4.90'	¥ N 89°-07'E,	<b>¥</b>	
and type of witness t	rees' and if off road	- best way to  N  O  1 1/2"X 24" IRON	87°- 54'W, 82 N PIPE SET	4.90'	Y N 89°-07'E, I I/2" X 24" I	3'19 <sub>1</sub> ,	
and type of witness t	rees' and if off road	- best way to  N  O  1 1/2"X 24" IRON	87°- 54'W, 82 N PIPE SET	4.90'	Y N 89°-07'E, I I/2" X 24" I	لا 9.19 RON PIPE SE	
and type of witness t	erees' and if off road	D Lest way to	87°- 54'W, 82	4.90' 200 100 100 100 100 100 100 100 100 100	Y N 89°-07'E, I I/2" X 24" I	لا 9.19 RON PIPE SE	
and type of witness to arrive at corner.  MAINTE  Date   Init.	ENANCE RECORI	D Dest way to	87°-54'W, 82 N PIPE SET ONLY ABOUT "OF HARBIS IS IN THE G	4.90' 200 100 100 100 100 100 100 100 100 100	Y N 89°-07'E, I I/2" X 24" I	لا 9.19 RON PIPE SE	
and type of witness to arrive at corner.  MAINTE  Date   Init.	ENANCE RECORI	D Lest way to	87°-54'W, 82 N PIPE SET ONLY ABOUT "OF HARBIS IS IN THE G	4.90' 200 100 100 100 100 100 100 100 100 100	Y N 89°-07'E, I I/2" X 24" I	لا 9,19' RON PIPE SE لا	
and type of witness to arrive at corner.  MAINTE  Date   Init.	ENANCE RECORI	D Dest way to	87°-54'W, 82 N PIPE SET ONLY ABOUT " OF HARRIS IS IN THE G	4.90' 200 100 100 100 100 100 100 100 100 100	Y N 89°-07'E, 1 1/2" X 24" 1	9.19' RON PIPE SE * LMP	Τ .
and type of witness to arrive at corner.  MAINTE  Date   Init.	ENANCE RECORI	D Dest way to	87°-54'W, 82 N PIPE SET ONLY ABOUT "OF HARBIS IS IN THE G	4.90' 200 100 100 100 100 100 100 100 100 100	Y N 89°-07'E, 1 1/2" X 24" 1	9.19' RON PIPE SE  MP  * 'X 24" IRON	

# ADAMS COUNTY Survey Monument

### Survey Monument Record

TYPE OF MONUMENT: HARRISON MON.
STATE PLANE COORDINATES: N\_\_\_\_\_\_

ELEVATION — M.S.L. DATUM: \_\_\_\_\_\_\_
THETA ANGLE: \_\_\_\_\_

FIELD BOOK: \_\_\_\_\_\_ PAGE \_\_\_\_\_

# \*---

SEAL:

LOCATION (Indicated by 'X')

CORNER NO. \_56

SECTION TOWN

RANGE

16

18 N

#### BASIS FOR MONUMENT LOCATION

(Use reverse side if necessary)

Show info such as: History of corner, with reference to Vol. and pg, dates, surveyor; exact description of monument replaced; if location computed, by taped or EDM traverse; landowner remarks, etc.

Ran EDM traverse around Section 16 and tied in all existing evidence.

Set West one-quarter corner on straight line in proportion to original ties.



CERATIFIED CORRECT:


Registered Land Surveyor

DATE: July 15, 1977

TIE SKETCH

(Show at least four ties)

Note: Ties in trees to #60 spikes.

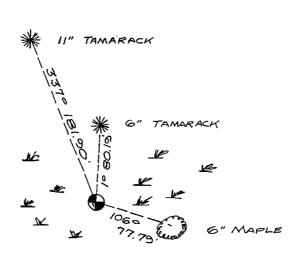

Dug extensive hole and found nothing.

4 N

