16 SECTION

OT RANGE ADAMS COUNTY COUNTY CORNER NO: 57 ROMPORTOL ID: 41807162000

PUBLIC LAND SURVEY MONUMENT RECORD

CALCULATED POSITION TYPE OF MONUMENT:

ADAMS COUNTY COORDINATES, NAD 83 (2007)

N. **242977.135**

E. 572814.029

FLEVATION-DATUM_


01/09/2020 FIELD WORK DATE:

BASIS FOR MONUMENT LOCATION


1978 - PLS 1184 USING A EDM TRAVERSE BEGINNING AT THE SE AND SW CORNERS OF SECTION 16, SET BY KIEDROWSKI, AND FOLLOWING THE ORIGINAL SECTION MEASUREMENTS, AS RECORDED IN VOL. 8, PG. 18 AND VOL. 3, PG. 6 OF 1901 AND 1925 SURVEY NOTES LOCATED THE WEST 1/4 POST OF SECTION 17 AND SET A MONUMENT AT THE BASE OF POST. THEN CALCULATED THE LOCATION OF AND SET THE E1/4 CORNER OF SECTION 16.

2011 - PLS 2663 FOUND NO EVIDENCE OF CORNER OR WITNESS MONUMENTS IN FARM FIELD, COMPUTED CORNER LOCATION ON LINE AND AT MID POINT BETWEEN THE NE CORNER AND SE CORNER OF SAID SECTION 16.

2020 - PLS 2675 NO MONUMENT WAS FOUND, RECOVERED 3 OF THE 4 TIES. THE CORNER WAS CALCULATED ON A STRAIGHT LINE, HALF WAY SPLIT BETWEEN THE NE AND SE CORNERS OF SECTION 16. THIS POSITION AGREES WITH THE 3 EXISTING TIES. ACCEPTED THIS CALCULATED POSITION AS THE CORNER LOCATION. SET 1 NEW TIE AND MEASURED TO THE EXISTING TIES.

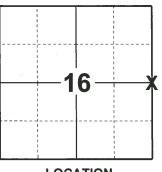

LOCATION (INDICATE CORNER BY "X")

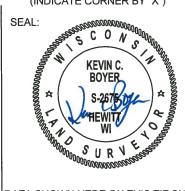


DATA SHOWN HERE ON THIS TIE SHEET IS CORRECT AND COMPLETE TO THE BEST OF MY KNOWLEDGE AND BELIEF.

PROFESSIONAL LAND SURVEYOR

-TIE SKETCH



- SET 3/4" x 18" IRON REBAR, 1.50#/FT
- FOUND 3/4" IRON ROD
- CALCATED POSITION
- FOUND HARRISON MONUMENT
- STEEL FENCE POST

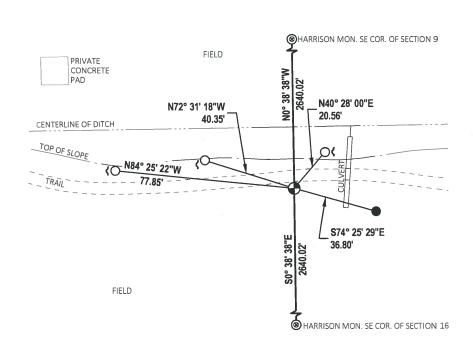

U.S. PUBLIC LAND SURVEY MONUMENT RECORD ADAMS COUNTY, WISCONSIN

CORNER NO. 57 CORNER NO. 41807162000

IN ACCORDANCE WITH WISCONSIN ADMINISTRATIVE CODE, CHAPTER A-E 7.08 (3) (A)-(I)

LOCATION. CHAPTER A-E 7.08 (3): (A)


SECTION 16 TOWNSHIP 18 NORTH RANGE 7 EAST

TOWN OF: RICHFIELD

TYPE OF CORNER: EAST QUARTER CORNER TYPE OF MONUMENT: NO MONUMENT SET HORIZONTAL DATUM: NAD 83-91 GRID

ADAMS COUNTY COORDINATES:

NORTHING: 242977.234 EASTING: 572814.045

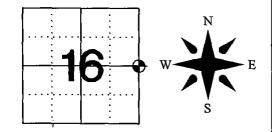


RECOVERY PROCEDURES: CHAPTER A-E 7.08 (3): (B), (F), (G), (H)

15 SEPT 1978 RLS 1184; USING AN E.D.M. TRAVERSE BEGINNING AT THE SE AND SW CORNERS OF SECTION 16, SET BY KIEDROWSKI, AND FOLLOWING THE ORIGINAL SECTION MEASUREMENTS, AS RECORDED IN VOL. 8, PAGE 18 AND VOL. 3, PAGE 6 OF 1901 AND 1925 SURVEY NOTES WE LOCATED THE WEST'A POST OF SECTION 17 AND SET A MONUMENT AT THE BASE OF POST. WE THEN CALCULATED THE LOCATION OF AND SET THE E% CORNER OF SECTION 16.

10-19-07 JG; COMPLETE AREA UNDER CULTIVATION, USE SECTION SUMMARY.

19 JANUARY 2011; FOUND NO EVIDENCE OF CORNER OR WITNESS MONUMENTS IN FARM FIELD. COMPUTED CORNER LOCATION ON LINE AND AT MID POINT BETWEEN THE NE CORNER AND SE CORNER OF SAID SECTION 16.

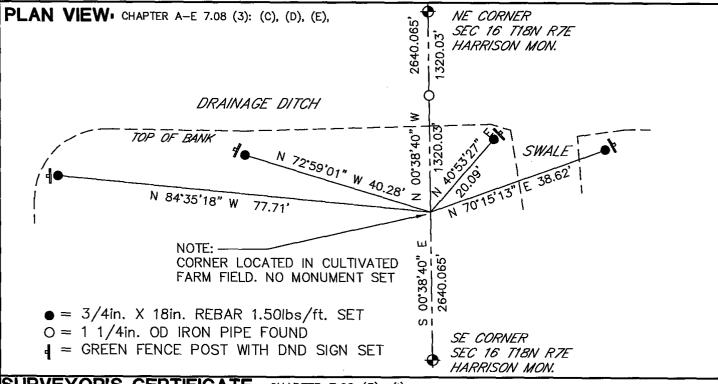

SURVEYOR'S CERTIFICATE: CHAPTER 7.08 (3): (1)

SCOV.

DARREN B KRZANOWSKI: S-2663 MOSINEE.

Manager SURVE

THE UNDERSIGNED HEREBY CERTIFIES THAT THE U.S. PUBLIC LAND SURVEY MONUMENT RECORD IS CORRECT AND COMPLETE TO THE BEST OF MY KNOWLEDGE AND BELIEF.

DARREN B. KRZMNOWSKI WISCONSIN LAND SURVEYOR S-2663 DATED THIS 21ST DAY OF JANUARY 2011

Government Land Corner Certificate CORNER NO. _ County ADAMS SECTION Harrison Std. TYPE OF MONUMENT: 18 N. TOWN STATE PLANE COORDINATES: N_ RANGE ELEVATION — M.S.L. DATUM: _ THETA ANGLE: _____ FIELD BOOK: __ __ PAGE __ DRAWN BY: ____ BASIS FOR MONUMENT LOCATION Show info such as: History of corner, with reference to Vol. and pg., dates, surveyor; exact description of monument replaced; if location computed, by taped or EDM traverse; landowner remarks, etc. (Use reverse side if necessary) SEAL: Using an E.D.M. traverse beginning at the SE and SW corners of Section 16, set by Kiedrowski, and following the original section measurements, as recorded in Vol. 8, Page 18 and Vol. 3, Page 6 of 1901 and 1925 survey notes we located the West 1/4 post of Section 17 and set a monument at the base of post. We then calculated the location of and set the E_{4}^{1} corner of Section 16 DATA SHOWN HERE ON CERTIFIED CORRECT: Land Surveyor DATE: TIE SKETCH Ł 11/2" X 24" IRON PIPE SET Show at least four ties, also fence lines, roads, topo, size and type of witness trees' and if off road - best way to 1 1/2" X 24" 1 BON PIPE SET arrive at corner. Ľ. SWAMP 土 业 Ľ Y 1 1/2" X 24" IRON PIPE SET MAINTENANCE RECORD Ł Date Init. Remarks COMPLETE AREA UNDER CULTIVATION SUMMARY JG Ľ 10-19-07 SWAMP

1 1/2" X 24" IRON PIPE