

PUBLIC LAND SURVEY MONUMENT RECORD

TYPE OF MONUMENT: HARRISON
 ADAMS COUNTY COORDINATES, NAD 83 (2007)

N. 242995.589

E. 578068.046


ELEVATION- _____ DATUM _____

FIELD WORK DATE: 01/17/2020

BASIS FOR MONUMENT LOCATION


1973 - PLS 878 EXCAVATED WITH BACKHOE. FOUND 8"X8"X13" DUG IN BLACK GRANITE STONE, FLAT ON TOP. WITNESSED BY LARRY BURROUGHS, ADJOINING LANDOWNER. LOWERED STONE AND SET HARRISON MONUMENT ON TOP. LOCATION VERIFIED BY EDM TRAVERSE.

2020 - PLS 2675 FOUND HARRISON MONUMENT 2"± BELOW THE ROAD SURFACE AND 2 TIES. THE MONUMENT AGREES WITH BOTH TIES. ACCEPTED THE HARRISON MONUMENT AS THE CORNER LOCATION. SET 2 NEW TIES AND MEASURED TO THE EXISTING TIES.

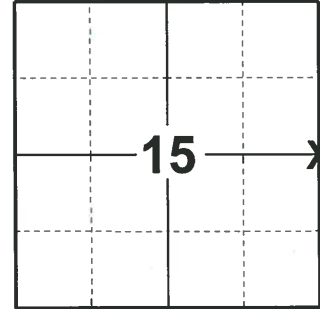

LOCATION
 (INDICATE CORNER BY "X")

SEAL:

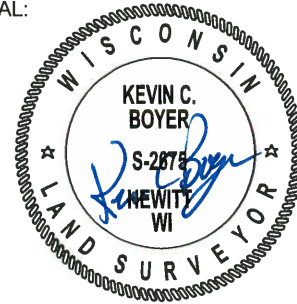



DATA SHOWN HERE ON THIS TIE SHEET IS CORRECT AND COMPLETE TO THE BEST OF MY KNOWLEDGE AND BELIEF.

PROFESSIONAL LAND SURVEYOR

DATE 3/9/2020

- TIE SKETCH

NOTE: THE CORNER LANDS 1.3'± WEST OF CENTERLINE OF 3RD AVE.

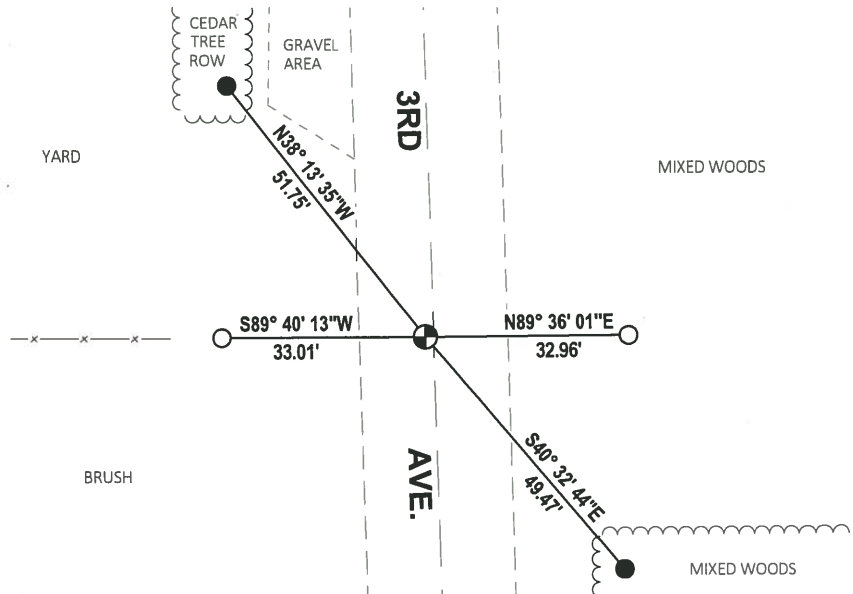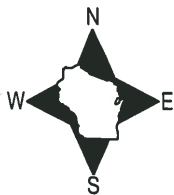


- SET 3/4" x 18" IRON REBAR, 1.50#/FT
- FOUND 3/4" IRON ROD
- ⊕ FOUND HARRISON MONUMENT
- ┘ STEEL FENCE POST
- VINYL "T" POST

Government Land Corner Certificate

ADAMS County
 TYPE OF MONUMENT: Harrison Monument
 STATE PLANE COORDINATES: N _____
 E _____
 ELEVATION — M.S.L. DATUM: _____
 THETA ANGLE: _____
 FIELD BOOK: 57 (101) PAGE 28 (112)
 DRAWN BY: Roger Nuber

CORNER NO. 58
 SECTION 15
 TOWN 18
 RANGE 7

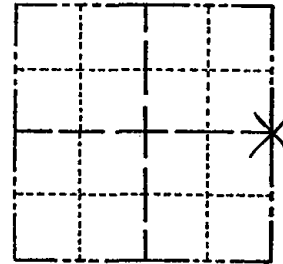

LOCATION
(Indicated by 'X')

BASIS FOR MONUMENT LOCATION

Show info such as: History of corner, with reference to Vol. and pg., dates, surveyor; exact description of monument replaced; if location computed, by taped or EDM traverse; landowner remarks, etc. (Use reverse side if necessary)

Excavated with backhoe. Found 8 x 8 x 13" dug in black granite stone, flat on top. Witnessed by Larry Burroughs, adjoining landowner. Lowered stone and set Harrison monument on top.

Location verified by EDM traverse.

SEAL:




DATA SHOWN HERE ON
CERTIFIED CORRECT:

Anthony B. Kiedrowski
Registered Land Surveyor

DATE: 1/13/78

TIE SKETCH

Show at least four ties, also fence lines, roads, topo, size and type of witness trees' and if off road - best way to arrive at corner.

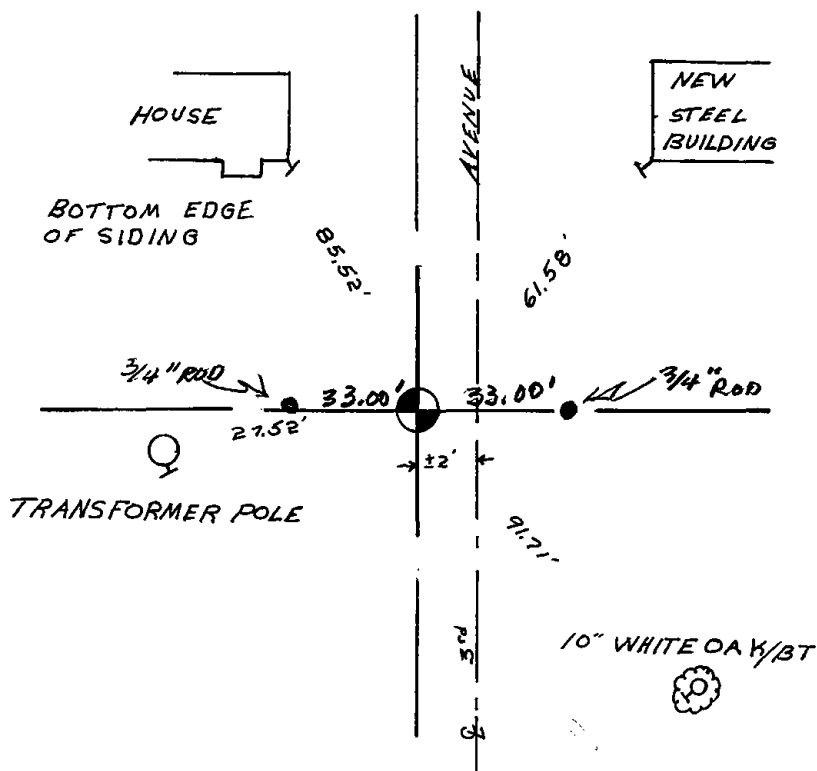

MAINTENANCE RECORD

Date	Init.	Remarks
5-17-82	PK-SS	O.K.
2-23-87	SS	"
11-26-91	KZ-SS	"
3-3-97	JG-SS	"
1-18-02	GR-JG	OK
4-11-01	JG	2-NEW TIES