ADAMS COUNTY COUNTY CORNER NO: 72 ROMPORTOL ID: 41807130020

PUBLIC LAND SURVEY MONUMENT RECORD

HARRISON TYPE OF MONUMENT: ADAMS COUNTY COORDINATES, NAD 83 (2007)

N. 240449.413

E. 586081.615


ELEVATION-DATUM_

01/23/2020 FIELD WORK DATE:


BASIS FOR MONUMENT LOCATION

1973 - PLS 878 SET HARRISON MONUMENT HALF WAY BETWEEN SECTION CORNERS, BUT NOT ON A STRAIGHT LINE, SINCE THIS FELL TOO FAR NORTH OF ROAD. DUG IN AREA WITH BACKHOE BUT FOUND NOTHING.

2020 - PLS 2675 FOUND HARRISON MONUMENT 8"± BELOW THE ROAD SURFACE AND DID NOT RECOVER ANY EXISTING TIES OR WITNESSES. THE MONUMENT IS EQUIDISTANT BETWEEN THE SW AND SE CORNERS, ACCEPTED THE HARRISON MONUMENT AS THE BEST EVIDENCE OF THE CORNER LOCATION. SET 3 NEW TIES AND MEASURED TO A FOUND PROPERTY IRON.

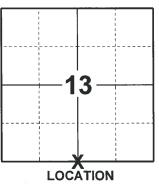

(INDICATE CORNER BY "X")

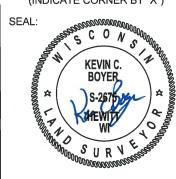


DATA SHOWN HERE ON THIS TIE SHEET IS CORRECT AND COMPLETE TO THE BEST OF MY KNOWLEDGE AND BELIEF.


PROFESSIONAL LAND SURVEYOR 2020

-TIE SKETCH

NOTE: THE CORNER LANDS 3.3'± NORTH OF CENTERLINE OF CUMBERLAND AVE.

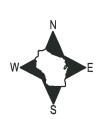

- SET 3/4" x 18" IRON REBAR, 1.50#/FT
- FOUND 3/4" IRON ROD
- FOUND HARRISON MONUMENT
- STEEL FENCE POST
- VINYL "T" POST

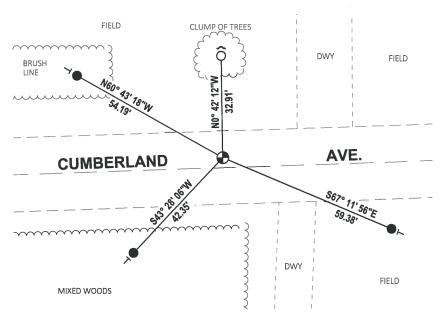

ADAMS COUNTY CORNER NO. _ SECTION Survey Monument Record TYPE OF MONUMENT: Harrison std. TOWN **RANGE** STATE PLANE COORDINATES: N. ELEVATION - M.S.L. DATUM: THETA ANGLE: . FIELD BOOK: ____108 PAGE _JO BASIS FOR MONUMENT LOCATION (Use reverse side if necessary) Show info such as: History of corner, with reference to Vol. and pg, dates, surveyor; exact description of monument replaced; if location computed, by taped or EDM traverse; landowner remarks, etc. Set half way between section corners, but not on a straight line, since this fell too far north of road. Dug in area with backhoe but found nothing. CORNER 0.K. 3-14.77 PK-SS 5-17-82 6R-55 CERTIFIED CORRECT: KZ-5G 12-4-91 Registered Land 12-18-97 NEW TIES DATE: JG TIE SKETCH 1-NEW YIE, 4-11-07-JG (Show at least four ties) Ties are to nail and disc. WHITE 8"BLK OAK '97 O CUMBERLAND AVE. FIELD