OT RANGE ADAMS COUNTY COUNTY CORNER NO: 78 ROMPORTOL ID: 41807222000

PUBLIC LAND SURVEY MONUMENT RECORD

HARRISON TYPE OF MONUMENT: ADAMS COUNTY COORDINATES, NAD 83 (2007)

N. **237743.165**

E. 578143.894


ELEVATION- - — — DATUM

01/15/2020 FIELD WORK DATE:___

BASIS FOR MONUMENT LOCATION


1981 - PLS 878 NO EVIDENCE OF M.C. SMITH POST COULD BE FOUND ALTHOUGH EXCAVATED A 10'X8' AREA WITH BACKHOE. CORNER IS RESET AS SMITH DID, ON LINE AND EQUIDISTANT BETWEEN SECTION CORNERS, IN THIS CASE, BOTH SECTION CORNER STONES WERE FOUND. (SEE VOL. 1, PG. 48 ADAMS COUNTY SURVEY RECORDS.)

2020 - PLS 2675 FOUND HARRISON MONUMENT 6"± BELOW THE ROAD SHOULDER, 2 TIES, AND 1 WITNESS. THE MONUMENT AGREES WITH THE TIES AND WITNESS. ACCEPTED THE HARRISON MONUMENT AS THE CORNER LOCATION. SET 4 NEW TIES AND MEASURED TO EXISTING THE TIES AND WITNESS.

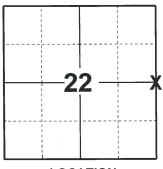

LOCATION

(INDICATE CORNER BY "X")

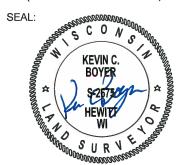

DATA SHOWN HERE ON THIS TIE SHEET IS CORRECT AND COMPLETE TO THE BEST OF MY KNOWLEDGE AND BELIEF.

PROFESSIONAL LAND SURVEYOR

-TIE SKETCH


NOTE: THE CORNER LANDS 9.5'± WEST OF 3RD AVE. CENTERLINE



- FOUND 1-1/4" IRON ROD
- FOUND HARRISON MONUMENT

SET 3/4" x 18" IRON REBAR, 1.50#/FT

- NW CORNER OF ELEC. PED.
- VINYL "T" POST

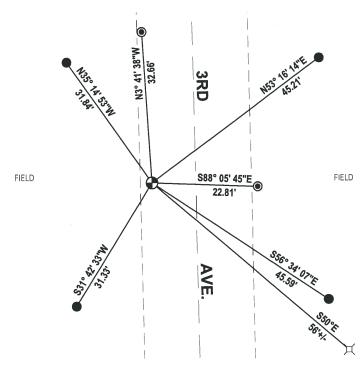

Government Land Corner Certificate 78 CORNER NO. ADAMS County 2**Z** SECTION TYPE OF MONUMENT: HARRISON 18 TOWN STATE PLANE COORDINATES: 7 RANGE ELEVATION — M.S.L. DATUM: THETA ANGLE: PAGE 55 FIELD BOOK: -DRAWN BY: L.COOMBS BASIS FOR MONUMENT LOCATION Show info such as: History of corner, with reference to Vol. and pg., dates, surveyor; exact description of monument replaced; if location computed, by taped or EDM traverse; landowner remarks, etc. (Use reverse side if necessary) ANTHONY B. KIEDROWS' S.P. SEAL: No evidence of M.C.Smith post could be found although excavated a 10 x 8 area with backhoe. Corner is reset as Smith did, On line and equidistant between section corners, in this case, both section corner stones were found. (see Vol 1, page 48 Adams County Survey records) SUR SUR DATA SHOWN HERE ON CERTIFIED CORRECT: Author, & Keo Registered Land Surveyor 10/7/81 DATE: TIE SKETCH Show at least four ties, also fence lines, roads, topo, size and type of witness trees' and if off road lest way to arrive at corner. ×24 IRON ROD NW eve ELECTRICAL TOP OF CAP TRANSFORMER 101t k 6" WELL

MAINTENANCE RECORD

<u>.</u>

DATE	BY WHOM	REMARKS
5-27-82	PK-SS	0 K
Z-18-87	22	I.P. TO EXET GONE - NO TIES AURICHOCE
7-6-92	JG - BS	2-GONE, 4-NEW, MON, OK
2-18-97	JG-55	0k
1-14-02	JG	OK
1-14-02	36	ok
02-28-12	MS	OK