OT RANGE ADAMS COUNTY C

PUBLIC LAND SURVEY MONUMENT RECORD

TYPE OF MONUMENT:	HARRISON (BROKEN-TOP)	
ADAMS COUNTY COORDIN	ATES NAD 83 (2007)	

N. 235017.086

E. 559666.240


ELEVATION-DATUM - -

01/23/2020 FIELD WORK DATE:


BASIS FOR MONUMENT LOCATION

1983 - PLS 1478 FOUND NO EVIDENCE OF ORIGINAL MONUMENTATION OR RESURVEYS. SET HARRISON MONUMENT ON LINE AT PROPORTIONATE DISTANCES FROM ADJACENT CORNERS.

2020 - PLS 2675 FOUND HARRISON (BROKEN-TOP) MONUMENT 12"± BELOW THE ROAD SURFACE, 1 TIE, AND 1 WITNESS. THE MONUMENT AGREES WITH THE TIE AND WITNESS. ACCEPTED THE HARRISON (BROKEN-TOP) MONUMENT AS THE CORNER LOCATION. SET 3 NEW TIES AND MEASURED TO THE EXISTING TIE AND WITNESS.

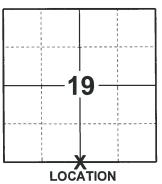

(INDICATE CORNER BY "X")

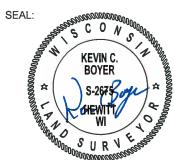

DATA SHOWN HERE ON THIS TIE SHEET IS CORRECT AND COMPLETE TO THE BEST OF MY KNOWLEDGE AND BELIEF.


PROFESSIONAL LAND SURVEYOR

-TIE SKETCH

NOTE: THE CORNER LANDS 3.2'± SOUTH OF CENTERLINE OF CYPRESS AVE




- SET 3/4" x 18" IRON REBAR, 1.50#/FT
- O FOUND 1-1/4" O.D. IRON PIPE
- FOUND HARRISON (BROKEN-TOP) MONUMENT
- POST
- STEEL FENCE POST
- VINYL "T" POST
- WITNESS TREE

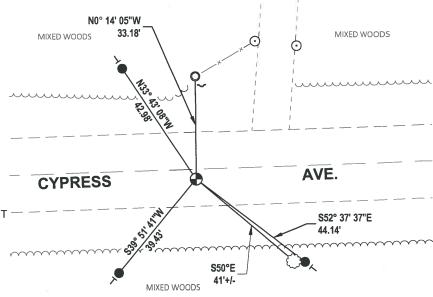

Government Land Corner Certificate

ADAMS		Cour	nty
TYPE OF MONU	IMENT: Harr	ison Standa	rd
STATE PLANE	COORDINATES:	N	
ELEVATION —	M.S.L. DATUM:		
	:3		154
DRAWN BY: _	Sorensen		

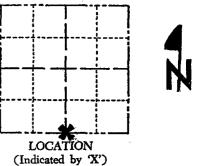


BASIS FOR MONUMENT LOCATION

Show info such as: History of corner, with reference to Vol. and pg., dates, surveyor; exact description of monument replaced; if location computed, by taped or EDM traverse; landowner remarks, etc. (Use reverse side if necessary)

Found no evidence of original monumentation or resurveys. Set monument on line at proportionate distances from adjacent corners.


 SEAL:

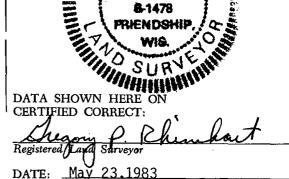

RHINEHART

TIE SKETCH

Show at least four ties, also fence lines, roads, topo, size and type of witness trees' and if off road - best way to arrive at corner.

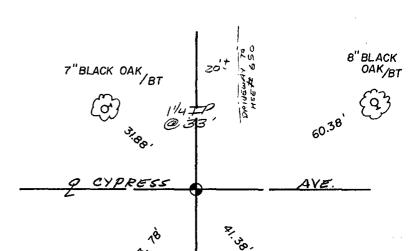

MAINTENANCE RECORD

Date	Init.	Remarks	
2-18-86	SE	OK	
11-22-91	KZ-50	OK	
-21-97.	56-55	OK	
-08-02	JE	ok_	
-23-07	J6-55	OK	
2-29-12	55	OK	

B"WHITE OAK, BT

