OT RANGE ADAMS COUNTY COUNTY CORNER NO: 83 ROMPORTOL ID: 41807190000

PUBLIC LAND SURVEY MONUMENT RECORD

HARRISON (BROKEN-TOP) TYPE OF MONUMENT: ADAMS COUNTY COORDINATES, NAD 83 (2007)

N. 235083.781

E. 562303.984

ELEVATION-DATUM - -

01/23/2020 FIELD WORK DATE:


BASIS FOR MONUMENT LOCATION

1983 - PLS 1478 SET HARRISON MONUMENT AT INTERSECTION OF FENCE LINE FROM NORTH AND CENTERLINE EXTENDED FROM WEST. THIS LOCATION BEST MATCHES RECORDED DISTANCES FROM ORIGINAL NOTES TO ADJACENT MONUMENTATION. EXCAVATION BY HAND YIELDED NO EVIDENCE OF PREVIOUS MONUMENTATION.

2020 - PLS 2675 FOUND HARRISON (BROKEN-TOP) 10"± BELOW THE ROAD SURFACE AND 1 WITNESS TREE. THE MONUMENT AGREES WITH THE WITNESS TREE. ACCEPTED THE HARRISON (BROKEN-TOP) MONUMENT AS THE CORNER LOCATION. SET 4 NEW TIES AND MEASURED TO THE WITNESS TREE.



(INDICATE CORNER BY "X")

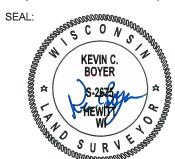


DATA SHOWN HERE ON THIS TIE SHEET IS CORRECT AND COMPLETE TO THE BEST OF MY KNOWLEDGE AND BELIEF.

PROFESSIONAL LAND SURVEYOR

-TIE SKETCH

NOTE: THE CORNER LANDS 9'± NORTH OF CENTERLINE OF CYPRESS AVE.



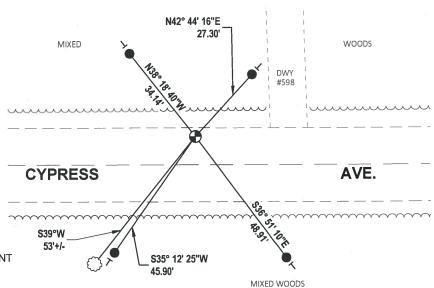


- SET 3/4" x 18" IRON REBAR, 1.50#/FT
 - FOUND HARRISON (BROKEN-TOP) MONUMENT
- VINYL "T" POST
- WITNESS TREE

Government Land Corner Certificate

ADAMS	County
ADAMS TYPE OF MONUMENT: Harriso	n Standard
STATE PLANE COORDINATES: N.	
E.	
ELEVATION — M.S.L. DATUM: _	·
THETA ANGLE:	
FIELD BOOK:3	PAGE153
DRAWN BY: Sorensen	

CORNER NO. SECTION TOWN RANGE

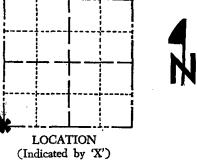

BASIS FOR MONUMENT LOCATION

Show info such as: History of corner, with reference to Vol. and pg., dates, surveyor; exact description of monument replaced; if location computed, by taped or EDM traverse; landowner remarks, etc. (Use reverse side if necessary)

Set monument at intersection of fenceline from north and centerline extended from west. location best matches recorded distances from original notes to adjacent monumentation. Excavation by hand yielded no evidence of previous monumentation.

filed for record this. UNE day of Wisconsin_Statutes ADAMS COUNTY SURVEYOR SEAL:



GONG

DATA SHOWN HERE ON CERTIFIED CORRECT:

Registered Land Surveyor
May 23, 1983 DATE:

TIE SKETCH

Show at least four ties, also fence lines, roads, topo, size and type of witness trees' and if off road - best way to arrive at corner.

9" TAMAR 4"BLACK 38' 95.04 AVE. G'BLACK 52.6 OAK 12 CO

MAINTENANCE RECORD

Date	Init.	Remarks
2-18-87	55	OK
11-22-91	KZ-56	OK
4-21-97	JG-55	360NE-3NEW TIES
r08-02	JG	OK
-23-67	5.55	OK
2-29-12	55	I NEW TIE

DEAD"

