

PUBLIC LAND SURVEY MONUMENT RECORD

TYPE OF MONUMENT: HARRISON
 ADAMS COUNTY COORDINATES, NAD 83 (2007)

N. 235004.281

E. 564977.230


ELEVATION- - - - DATUM - - - -

FIELD WORK DATE: 01/13/2020

BASIS FOR MONUMENT LOCATION

1981 - PLS 1478 RESET CORNER FROM ORIGINAL WHITE OAK B.T. S60°W 46 LINKS (30.36'). M.C. SMITH NOTES IN VOL. 2, PG. 96 A.C.S.R., THAT HE FOUND POST AND BEARING AT THIS POINT IN JULY 1908. THIS FITS WELL WITH THE SOUTH LINE OF SECTION 21-18-07.


2020 - PLS 2675 FOUND HARRISON MONUMENT FLUSH WITH THE GROUND AND 3 WITNESS TREES. THE MONUMENT AGREES WITH ALL 3 WITNESS TREES. ACCEPTED THE HARRISON MONUMENT AS THE CORNER LOCATION. SET 4 NEW TIES AND MEASURED TO THE EXISTING WITNESS TREES.

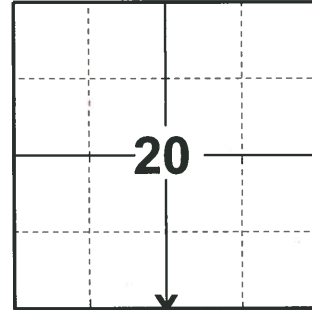

LOCATION

(INDICATE CORNER BY "X")

SEAL:

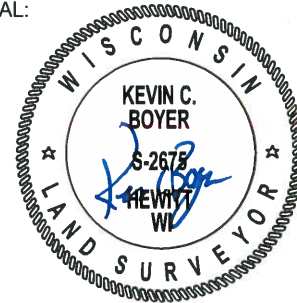



DATA SHOWN HERE ON THIS TIE SHEET IS CORRECT AND COMPLETE TO THE BEST OF MY KNOWLEDGE AND BELIEF.

PROFESSIONAL LAND SURVEYOR

DATE 3/9/2020

- TIE SKETCH

NOTE: THE CORNER LANDS 57'± SOUTH OF CENTERLINE OF CYPRESS AVE.

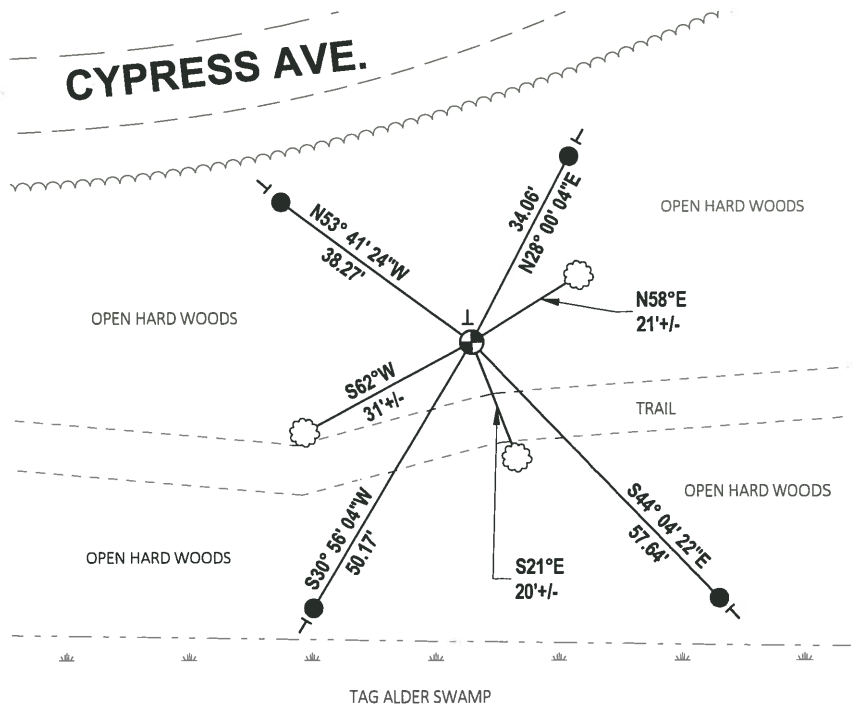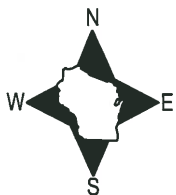

- SET 3/4" x 18" IRON REBAR, 1.50#/FT
- ⊕ FOUND HARRISON MONUMENT
- ⊖ VINYL "T" POST
- ☼ WITNESS TREE

Government Land Corner Certificate

ADAMS County

TYPE OF MONUMENT: 3/4" x 2 1/2" Iron Rod / replace spring '81 STANDARD HARRISON SET 2-19-81

STATE PLANE COORDINATES: N _____
E _____


ELEVATION — M.S.L. DATUM: _____

THETA ANGLE: _____

FIELD BOOK: 3 PAGE 37

DRAWN BY: S. Sorensen

CORNER NO. 84
SECTION 20
TOWN 18
RANGE 7

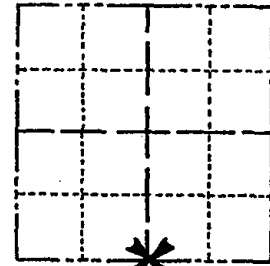

LOCATION
(Indicated by 'X')

BASIS FOR MONUMENT LOCATION

Show info such as: History of corner, with reference to Vol. and pg., dates, surveyor; exact description of monument replaced; if location computed, by taped or EDM traverse; landowner remarks, etc. (Use reverse side if necessary)

Reset corner from original white oak B.T. S60°W 46 links (30.36'). M.C. Smith notes in Vol. 2, pg. 96 A.C.S.R., that he found post and bearings at this point in July 1908. This fits well with the south line of section 21-18-7.

SEAL:




DATA SHOWN
CERTIFIED CORRECT:

Gregory P. Rhinehart
Registered Land Surveyor

DATE: 2-24-81

TIE SKETCH

Show at least four ties, also fence lines, roads, topo, size and type of witness trees' and if off road - best way to arrive at corner.

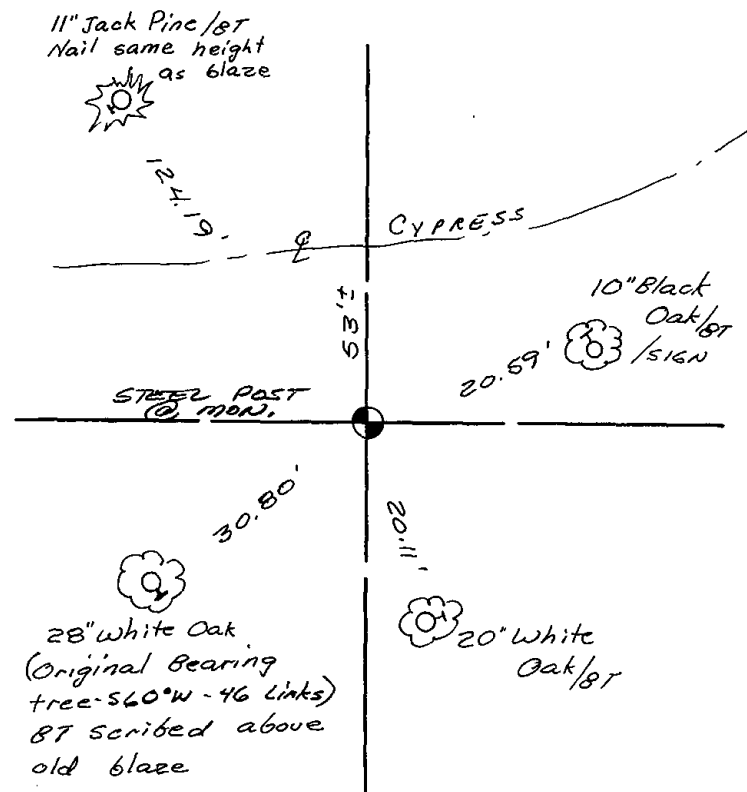

MAINTENANCE RECORD

Date	Init.	Remarks
8-17-82	PK-SS	O.K.
2-18-87	SS	OK
11-22-91	JK-SG	OK
4-21-97	JG-SS	OK
1-08-02	JG	OK
3-23-07	JG-SS	OK
02-29-12	SS	OK

