# OT RANGE ADAMS COUNTY COUNTY CORNER NO: 91 ROMPORTOL ID: 41807230000

## PUBLIC LAND SURVEY MONUMENT RECORD

**HARRISON** TYPE OF MONUMENT: ADAMS COUNTY COORDINATES, NAD 83 (2007)

N. 235118.087

E. 583458.844

**ELEVATION-**

DATUM

FIELD WORK DATE:

02/05/2020

#### BASIS FOR MONUMENT LOCATION

1981 - PLS 878 EXCAVATED 8'X10' HOLE AT THE CENTERLINE-CENTERLINE OF ROADS, FOUND NOTHING. AFTER ANALYZING A TRAVERSE OF SECTIONS 24, 25, & 36, RETURNED TO EXCAVATE 35' FURTHER NORTH, AGAIN FOUND NOTHING. THE NORTH-SOUTH LOCATION OF THIS CORNER IS SET BY PROPORTIONAL MEASUREMENT OF THE DISTANCE BETWEEN THE SW CORNER OF SECTION 36 AND THE NW CORNER OF SECTION 24. EAST-WEST LOCATION IS SET BY DOUBLING THE DISTANCE BETWEEN SECTION MONUMENTS AT THE SW AND S1/4 CORNERS OF SECTION 23. BEING STONE AND FLAT IRON BAR.

2020 - PLS 2675 FOUND HARRISON MONUMENT 6"± BELOW THE ROAD SURFACE AND 1 WITNESS. THE MONUMENT AGREES WITH THE WITNESS. ACCEPTED THE HARRISON MONUMENT AS THE CORNER LOCATION. SET 4 NEW TIES AND MEASURED TO THE EXISTING WITNESS.



(INDICATE CORNER BY "X")




DATA SHOWN HERE ON THIS TIE SHEET IS CORRECT AND COMPLETE TO THE BEST OF MY KNOWLEDGE AND BELIEF.

PROFESSIONAL LAND SURVEYOR 2070

#### -TIE SKETCH

NOTE: THE CORNER LANDS 1'± WEST OF CTH "G" CENTERLINE AND 36'± NORTH OF CYPRESS AVE. CENTERLINE



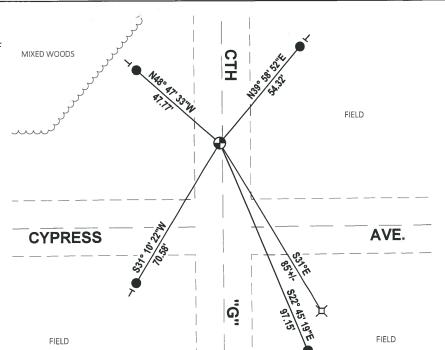

SET 3/4" x 18" IRON REBAR, 1.50#/FT

FOUND HARRISON MONUMENT

VINYL "T" POST

Government Land Corner	<u>Certificate</u>	CORNE	NO 91
AOAMS	_County	CORNER	25
TYPE OF MONUMENT:	0/1	TOWN	
		RANGE	7
elevation — m.s.l. datum: theta angle: field book:88 drawn by:L. Coom/35		<del>                                      </del>	4
BASIS FOR MONUMENT LOCAT	ION		NI IN
Show info such as: History of corner, with rand pg., dates, surveyor; exact description replaced; if location computed, by taped or landowner remarks, etc. (Use reverse side if	reference to Vol.	LOCATIO (Indicated by	
Excavated 8'x10' hole at the line of roads, found nothing a traverse of Sections 24, 2 to excavate 35' further Northothing. The North-South lower of the Sw corner of the NW corner of Section 24. is set by doubling the distant and set by doubling the distant and Stantant at the Sw and Swantant at the Swantant at	After analyzing  & 36, returned  h, again found  cation of this corner  rement of the dis-  of Section 36 and  East-West location  nce between Section  orners of Section	String N S C	HONY B. DROWSKI S-878 Insin Rapids, Wis. URVERINGER  ON  CON
TIE SKETCH  Show at least four ties, also fence lines, road and type of witness trees' and if off road - arrive at corner.	ls, topo, size best way to	*	
6" NORWAY MY PINE/BT EN	89.75.	× × Ø 24" OAK/BT	nÉ
CYPRESS	104. 3	NW CORNER ELECTRIC BOX	X—X—X—X SPIBT AVE
·		SP 129 <i>5</i> 6	

### MAINTENANCE RECORD

DATE	BY WHOM	REMARKS	
5-27-82	PK-SS	O.K.	
4-6-81	6R-55	6C 2 rev 7165	
12-4-91	KZ JG	OK.	
2-17-97	JG-55	OK	
1-14-02	JG	OK	
4-3-07	76	O/K	
2-27-12	MS-SS	I NEW TIE	