

27
SECTION

18
TOWN

07
RANGE

ADAMS COUNTY

COUNTY CORNER NO: 98

ROMPORTOL ID: 41807272000

PUBLIC LAND SURVEY MONUMENT RECORD

TYPE OF MONUMENT: 3/4" IRON ROD
ADAMS COUNTY COORDINATES, NAD 83 (2007)

N. 232466.479

E. 578206.803


ELEVATION- - - - DATUM - - - -

FIELD WORK DATE: 02/06/2020

BASIS FOR MONUMENT LOCATION

1981 - PLS 878 FOUND STUMPS OF BOTH BEARING TREES CALLED FOR IN THE ORIGINAL NOTES. SET HARRISON FROM BT'S. EXCAVATED WITH BACKHOE- MUCH LEDGE ROCK. FOUND DARK SPOT IN SOIL BUT COULD NOT IDENTIFY A SPECIFIC POINT.


2020 - PLS 2675 FOUND A 3/4" IRON ROD 4"± BELOW THE ROAD SHOULDER, 2 TIES, AND 2 WITNESSES. FOUND NO EVIDENCE OF A HARRISON MONUMENT. THE 3/4" IRON ROD AGREES WITH THE TIES AND WITNESSES. ACCEPTED THE 3/4" IRON ROD AS THE CORNER LOCATION. SET 2 NEW TIES AND MEASURED TO THE EXISTING TIES AND WITNESSES.

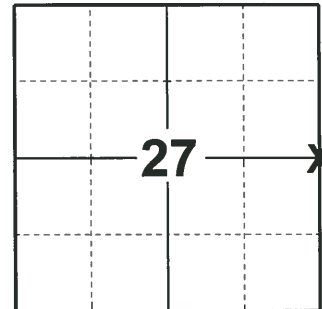

LOCATION

(INDICATE CORNER BY "X")

SEAL:

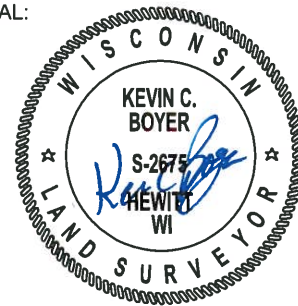



DATA SHOWN HERE ON THIS TIE SHEET IS CORRECT AND COMPLETE TO THE BEST OF MY KNOWLEDGE AND BELIEF.

PROFESSIONAL LAND SURVEYOR

DATE 3/9/2020

- TIE SKETCH

NOTE: THE CORNER LANDS 11.5'± WEST OF THE CENTERLINE OF 3RD AVE.

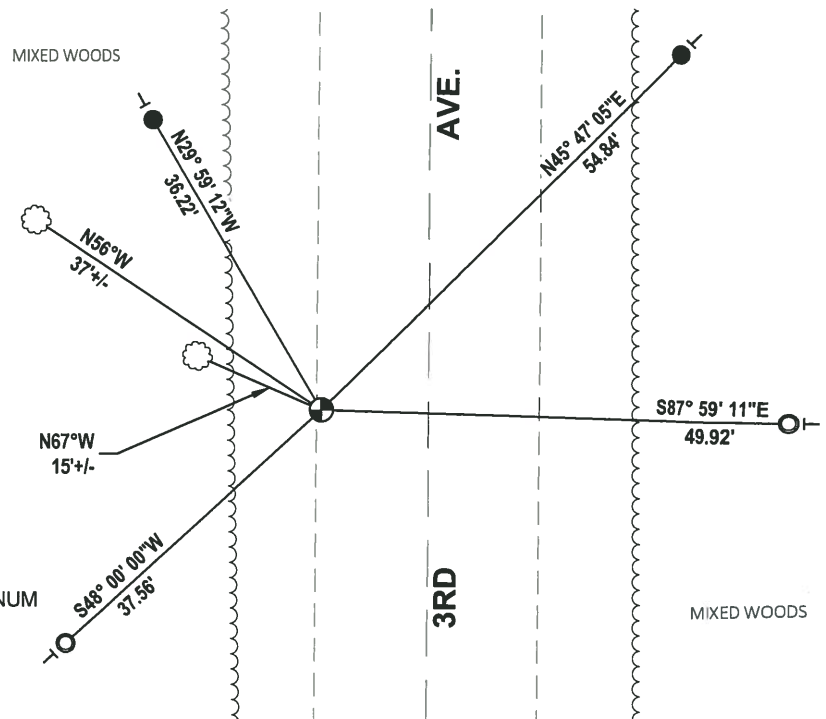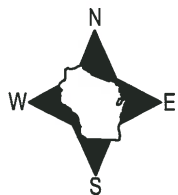


- SET 3/4" x 18" IRON REBAR, 1.50#/FT
- FOUND 1-1/4" O.D. IRON PIPE W/ADAMS CO. ALUMINUM
- ⊕ CAP
- FOUND 3/4" IRON ROD
- ☼ VINYL "T" POST
- WITNESS TRFF

Government Land Corner Certificate

ADAMS County
 TYPE OF MONUMENT: HARRISON
 STATE PLANE COORDINATES: N _____
 E _____
 ELEVATION — M.S.L. DATUM: _____
 THETA ANGLE: _____
 FIELD BOOK: 88 PAGE 53
 DRAWN BY: L. COOMBS

CORNER NO. 98
 SECTION 26
 TOWN 18
 RANGE 7

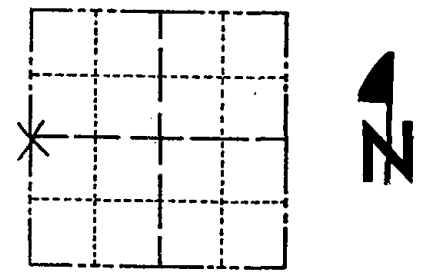

LOCATION
 (Indicated by 'X')

BASIS FOR MONUMENT LOCATION

Show info such as: History of corner, with reference to Vol. and pg., dates, surveyor; exact description of monument replaced; if location computed, by taped or EDM traverse; landowner remarks, etc. (Use reverse side if necessary)

Found stumps of both bearing trees called for in the original notes. Set corner from BT's. Excavated with backhoe - much ledge rock. Found dark spot in soil but could not identify a specifi- point.

SEAL:



DATA SHOWN HERE ON
 CERTIFIED CORRECT:

Anthony B. Kiedrowski
 Registered Land Surveyor

DATE: 10/7/81

TIE SKETCH

Show at least four ties, also fence lines, roads, topo, size and type of witness trees' and if off road - best way to arrive at corner.

