OT RANGE ADAMS COUNTY COUNTY CORNER NO: 102 ROMPORTOL ID: 41807300020

PUBLIC LAND SURVEY MONUMENT RECORD

HARRISON (BROKEN-TOP) TYPE OF MONUMENT: ADAMS COUNTY COORDINATES, NAD 83 (2007)

N. 229730.783

E. 559710.106


ELEVATION-DATUM - ---

01/16/2020 FIELD WORK DATE:


BASIS FOR MONUMENT LOCATION

1977 - PLS 1478 RAN EDM/T2 TRAVERSE AROUND SECTION 31 & 32 AND TO ADJOINING SECTION CORNERS TO DETERMINE SEARCH AREAS FOR INVESTIGATION. EXCAVATION WITH BACKHOE YIELDED NO EVIDENCE OF THE ORIGINAL CORNER OF ANY SUBSEQUENT REMONUMENTATION. COULD FIND NO EVIDENCE OF ANY BEARING TREES, RELOCATED CORNER BY SINGLE PROPORTIONATE MEASURE BETWEEN ADJACENT SECTION CORNERS. SET HARRISON MONUMENT.

2020 - PLS 2675 FOUND HARRISON (BROKEN-TOP) MONUMENT 12"± BELOW THE ROAD SURFACE, 2 TIES, AND 2 WITNESSES. THE MONUMENT AGREES WITH ALL TIES AND WITNESSES. ACCEPTED THE HARRISON (BROKEN-TOP) MONUMENT AS THE CORNER LOCATION. SET 2 NEW TIES AND MEASURED TO A FOUND PROPERTY IRON, EXISTING TIES, AND WITNESSES.

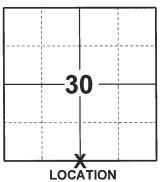

(INDICATE CORNER BY "X")

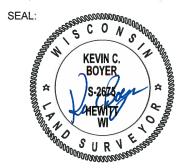

DATA SHOWN HERE ON THIS TIE SHEET IS CORRECT AND COMPLETE TO THE BEST OF MY KNOWLEDGE AND BELIEF.

PROFESSIONAL LAND SURVEYOR 12020

-TIE SKETCH

NOTE: THE CORNER LANDS 7'± SOUTH OF THE CENTERLINE CZECH AVE.



OPEN MARSH Alle AVE. **CZECH** \$570 -43'49'E \$75°E 43'+/ S9°W S9° 21' 58"E S1° 45' 29' 30'+/-33.18 16.24 MIXED WOODS

- SET 3/4" x 18" IRON REBAR, 1.50#/FT
- FOUND 1.0 O.D. IRON PIPE
- O FOUND 1-1/4" O.D. IRON PIPE W/ADAMS CO. ALUMINUM CAP
- FOUND HARRISON (BROKEN-TOP) MONUMENT
- VINYL "T" POST
- WITNESS TREE

Government Land Corner Certificate

_County
PAGE/8

CORNER NO. 202 SECTION TOWN RANGE TOWN RANGE TOWN RANGE TOWN RANGE TOWN RANGE

LOCATION

(Indicated by 'X')

BASIS FOR MONUMENT LOCATION

Show info such as: History of corner, with reference to Vol. and pg., dates, surveyor; exact description of monument replaced; if location computed, by taped or EDM traverse; landowner remarks, etc. (Use reverse side if necessary)

Ran EDM/T2 traverse around Sections 31 and 32 and to adjoining section corners to determine search areas for investigation.

Excavation with backhoe yielded no evidence of the original corner or any subsequent remonumentation. Could find no evidence of any bearing trees.

Relocated corner by single proportionate measure between adjacent section corners.

Set Harrison on 8-15-77.

DATA SHOWN HERE ON CERTIFIED CORRECT:

Registered Land Surveyor

DATE: 9-14-77

TIE SKETCH


Show at least four ties, also fence lines, roads, topo, size and type of witness trees' and if off road - best way to arrive at corner.

NOTES:

- 1) Ties in trees to nail in disc.
- 2) Corner falls in what appears to be an old road bed to the South, which runs into marsh about 200 feet South of corner.

MAINTENANCE RECORD

	1	VIAIN I E	ENANCE RECORD	
	Date	Init.	Remarks	_
8-2	5-82.	PK-SS	TOP BROKEN-BOTTOM IN	PLACE
2-/	0-87	ِ کک	OK	
11-2	2-91	KZ-56	OK	
2-17-		16-55	2-NEW TIES, 1-GONE	
1-0	8-07	36	OK	
3-2	3-01.	84.55	OK	

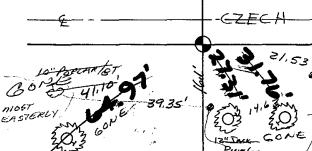

7" Jack Property

REVISED 1977