# OT RANGE ADAMS COUNTY COUNTY CORNER NO: 105 ROMPORTOL ID: 41807290000

# PUBLIC LAND SURVEY MONUMENT RECORD

**HARRISON** TYPE OF MONUMENT: ADAMS COUNTY COORDINATES, NAD 83 (2007)

N. 229770.057

E. 567653.073


\_ DATUM - -----**ELEVATION-**

01/16/2020 FIELD WORK DATE:


#### BASIS FOR MONUMENT LOCATION

1977 - PLS 1103 RAN EDM/T2 TRAVERSE AROUND SECTION 31 & 32, AND TO ADJACENT SECTION CORNERS TO DETERMINE SEARCH AREA FOR INVESTIGATION, EXCAVATION WITH BACKHOE YIELDED NO EVIDENCE OF THE ORIGINAL CORNER OR REMONUMENTATION. COULD FIND NO EVIDENCE OF ORIGINAL BEARING TREES. AFTER WEIGHING OCCUPATION AND DISTANCES, CONCLUDED THE RELOCATED CORNER BE PLACED ON THE CENTERLINE OF CZECH AVE AND OPPOSITE ANCIENT FENCE TO THE SOUTH. SET HARRISON MONUMENT.

2020 - PLS 2675 FOUND HARRISON MONUMENT 18"± BELOW THE ROAD SURFACE AND 3 WITNESS TREES. THE MONUMENT AGREES WITH ALL 3 WITNESS TREES. ACCEPTED THE HARRISON MONUMENT AS THE CORNER LOCATION, SET 3 NEW TIES AND MEASURED TO A FOUND PROPERTY IRON AND THE WITNESS TREES.

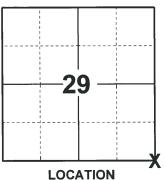

(INDICATE CORNER BY "X")

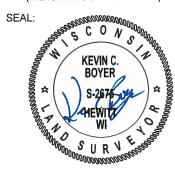

DATA SHOWN HERE ON THIS TIE SHEET IS CORRECT AND COMPLETE TO THE BEST OF MY KNOWLEDGE AND BELIEF.


PROFESSIONAL LAND SURVEYOR

#### -TIE SKETCH

NOTE: THE CORNER LANDS 0.8'± SOUTH OF CENTERLINE OF CZECH AVE.



- SET 3/4" x 18" IRON REBAR, 1.50#/FT
- FOUND 3/4" IRON ROD
- FOUND HARRISON MONUMENT
- STEEL FENCE POST
- VINYL "T" POST
- WITNESS TREE

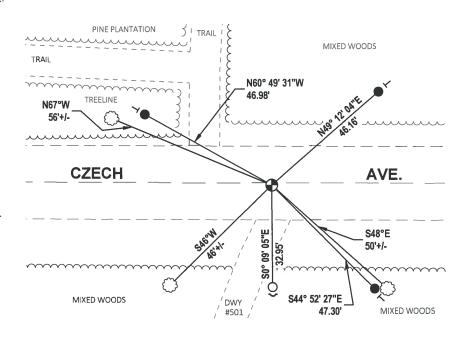

# **Government Land Corner Certificate**

Adams	County
TYPE OF MONUMENT: HARRIS	o N
STATE PLANE COORDINATES: N	N
F	<u> </u>
ELEVATION — M.S.L. DATUM:	
THETA ANGLE:	
	PAGE
DRAWN BY: D.C. H.	

## BASIS FOR MONUMENT LOCATION

Show info such as: History of corner, with reference to Vol. and pg., dates, surveyor; exact description of monument replaced; if location computed, by taped or EDM traverse; landowner remarks, etc. (Use reverse side if necessary)

Ran EDM/T2 traverse around Sections 31 & 32, and to adjacent section corners to determine search area for investigation.

Excavation with backhoe yielded no evidence of the original corner or remonumentation. Could find no evidence of original bearing trees.

After weighing occupation and distances, concluded the relocated corner be placed on the centerline of Czech Avenue and opposite ancient fence to the South.

Set Harrison on 8-15-77.

CORNER NO. SECTION 18 TOWN **RANGE** 



SEAL:

DALE C.
HAGEN
S-1103
Wisconsin Rapids,
Wis.

DATA SHOWN HERE ON CERTIFIED CORRECT:

Registered Land Surveyor

9-14-77 DATE:

### TIE SKETCH

Show at least four ties, also fence lines, roads, topo, size and type of witness trees' and if off road - best way to arrive at corner.

NOTE

Ties in trees to nail in disc.

16" BIK. OAK/BT.

14" BIK OA

MAINTENANCE RECORD

Date	Init.	Remarks	
3-26-8Z	6R-55	OK	
2-10-87	55	"	
11-22-91	KZ-J6	OK	
1-17-97	JG-55	6K	
2-03-07	GR	OK	
3-23-07	56-55	OK	