OT RANGE ADAMS COUNTY COUNTY CORNER NO: 110 ROMPORTOL ID: 41807260020

PUBLIC LAND SURVEY MONUMENT RECORD

HARRISON TYPE OF MONUMENT: ADAMS COUNTY COORDINATES, NAD 83 (2007) N. 229842.597 E. 580856.820 **ELEVATION-**DATUM - — —


FIELD WORK DATE:

02/06/2020


BASIS FOR MONUMENT LOCATION

1979 - PLS 878 EXCAVATED WITH BACKHOE. FOUND BOTTOM 12" OF 3" DIAMETER ROTTED WOOD POST, SET HARRISON MONUMENT AT THAT POINT, COULD FIND NO RECORD OF ANY RESURVEYS. LOCATION VERIFIED BY EDM TRAVERSE.

2020 - PLS 2675 FOUND A HARRISON MONUMENT 18"± BELOW THE ROAD SURFACE AND DID NOT RECOVER ANY TIES OR WITNESSES. ACCEPTED THE HARRISON AS THE CORNER LOCATION, SET 4 NEW TIES.

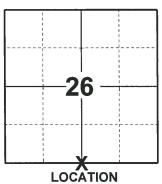

(INDICATE CORNER BY "X")

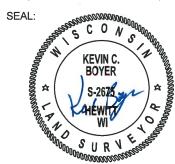


DATA SHOWN HERE ON THIS TIE SHEET IS CORRECT AND COMPLETE TO THE BEST OF MY KNOWLEDGE AND BELIEF.

PROFESSIONAL LAND SURVEYOR 2020

-TIE SKETCH

NOTE: THE CORNER LANDS 0.5'± NORTH OF CZECH AVE.



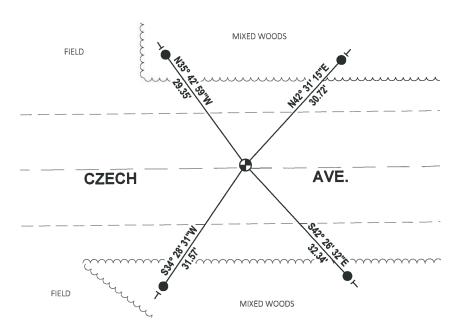

- SET 3/4" x 18" IRON REBAR, 1.50#/FT
- FOUND HARRISON MONUMENT
- VINYL "T" POST

Government Land Corner Certificate CORNER NO. ADAMS County SECTION TYPE OF MONUMENT: STANDARD HARRISON 18 TOWN STATE PLANE COORDINATES: N_ RANGE ELEVATION — M.S.L. DATUM: THETA ANGLE: _ FIELD BOOK: 102 (DIGGING) _ PAGE __<u>39</u> DRAWN BY: PAUL KIEDROWSKI BASIS FOR MONUMENT LOCATION ANTHONY B. KIEDROWSKI S-878 Wisconsin P Show info such as: History of corner, with reference to Vol. and pg., dates, surveyor; exact description of monument replaced; if location computed, by taped or EDM traverse; landowner remarks, etc. (Use reverse side if necessary) SEAL: Excavated with backhoe. Found bottom 12" of 3" dia rotted wood post. Set Harrisonmonument at that point. Could find no record of any resurveys. Location verified by EDM traverse. DATA SHOWN HERE ON CERTIFIED CORRECT: A Registered Land Surveyor DATE: 8/2/79 TIE SKETCH DEAD Show at least four ties, also fence lines, roads, topo, size and type of witness trees' and if off road - best way to " RED OAK ES 5"BLACK BT 62.50 OAK arrive at corner. JACK-PINE & CZECH (DIRT) ALL TIES TO NAIL & DISC 34.40 6"JACK RED OAK PINE 12 BT. PINE 12 GONE"

MAINTENANCE RECORD

DATE	BY WHOM	REMARKS
5-20-82	PK SS	C, &,
Z-20-87	55	Z NEW TIES
12-2-91	55-8G	OK
12/18/97	55-JC	OK
1-14-02	J6	OK
4-10-07	J6	OK
03-08-12	MS-SS	3 NEW 1765