OT RANGE ADAMS COUNTY COUNTY CORNER NO: 112 ROMPORTOL ID: 41807250020

PUBLIC LAND SURVEY MONUMENT RECORD

SURVEY NAIL TYPE OF MONUMENT: ADAMS COUNTY COORDINATES, NAD 83 (2007) N. **229877.164** E. 586151.138 ELEVATION-_ DATUM - — —

02/05/2020

BASIS FOR MONUMENT LOCATION


FIELD WORK DATE:_

1981 - PLS 878 NO RECORD OF RESURVEY. DID NOT EXCAVATE SINCE SEARCH AREA FALLS IN DITCH AREA. CORNER SET ON LINE AND EQUIDISTANT BETWEEN SECTION CORNERS.

2020 - PLS 2675 FOUND MAGNAIL IN ROAD SURFACE AND 2 WITNESSES. REMOVED MAGNAIL, FOUND NO OTHER EVIDENCE OF ANY OTHER MONUMENT BELOW. THE MAGNAIL POSITION AGREES WITH BOTH WITNESSES AND IS ON A NEAR STRAIGHT LINE BETWEEN THE SE AND SW CORNERS OF SECTION 25 AND EQUIDISTANT SPLIT. ACCEPTED THE MAGNAIL POSITION AS THE CORNER LOCATION. SET A SURVEY NAIL IN THE MAGNAIL POSITION. SET 4 NEW TIES AND MEASURED TO THE EXISTING WITNESSES.



(INDICATE CORNER BY "X")

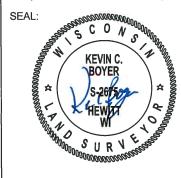

DATA SHOWN HERE ON THIS TIE SHEET IS CORRECT AND COMPLETE TO THE BEST OF MY KNOWLEDGE AND BELIEF.


PROFESSIONAL LAND SURVEYOR 1000

-TIE SKETCH

NOTE: THE CORNER LANDS 22'± NORTH OF CTH "CC" CENTERLINE AND 18'± EAST OF 1ST DR CENTERLINE



- SET 3/4" x 18" IRON REBAR, 1.50#/FT
- FOUND SURVEY NAIL MONUMENT
- M NW CORNER OF ELEC. PED.
- **GUY POLE**
- VINYL "T" POST

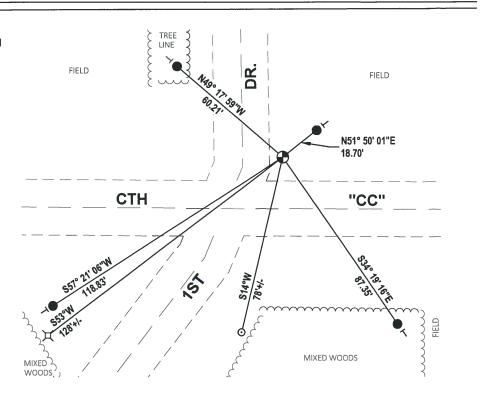

ADAMS	County		NER NO. 112
	HARRISON FOPK NAIL OZ	SECT	
STATE PLANE COORDINATE		TOW	n <u>18</u>
	Е	RAN	GE <u>7</u>
ELEVATION — M.S.L. DAT	UM:	h	
THETA ANGLE:			
	PAGE		
PRAWN BY: <u>L. COO</u>	785	<u> </u>	
		=	IN
SASIS FOR MONUMENT	LOCATION		
how info such as: History of con	tner, with reference to Vol.		
nd pg., dates, surveyor; exact eplaced; if location computed, bandowner remarks, etc. (Use rev	y taped or EDM traverse;		ATION
indowner remarks, etc. (Use rev	erse side if necessary)	CEAL.	d by 'X')
	ys. Did not excavate	SEAL WIS	111111111111111111111111111111111111111
	lls in ditch area. Corner	in 15	CONSINIA
corners.	distant between Section	Sall W.	
		AN S / AN	THONY B. EDROWSKI
		ar Wis	consin Rapids,
			ms.
		4 0	E
		*****	SURVINION
		DATA CHOMM I	EDE ON
		DATA SHOWN H CERTIFIED CORR	ERE ON ECT:
		A +1 0	BKechens
		Registered Land Sur	еуот
		DATE:10/7/	81
	•		
TE SKETCH	•		
now at least four ties, also fence	lines, roads, topo, size		
how at least four ties, also fence ad type of witness trees' and if	e lines, roads, topo, size off road - best way to		
how at least four ties, also fence ad type of witness trees' and if rive at corner.	off road - best way to WHITE OAK/		
how at least four ties, also fence ad type of witness trees' and if rive at corner.	off road - best way to		
how at least four ties, also fence ad type of witness trees' and if rive at corner.	off road - best way to WHITE OAK/ BT. SI		
how at least four ties, also fence ad type of witness trees' and if rive at corner.	off road - best way to WHITE OAK/ BT. SI		
how at least four ties, also fence ad type of witness trees' and if rive at corner.	off road - best way to WHITE OAK/ BT. SI		
how at least four ties, also fence ad type of witness trees' and if rive at corner.	off road - best way to WHITE OAK ON ON ON ON ON ON ON ON ON O		
how at least four ties, also fence nd type of witness trees' and if rive at corner.	off road - best way to WHITE OAK/ BT. SI		
	off road - best way to WHITE OAK S S N		
how at least four ties, also fence nd type of witness trees' and if rive at corner. /2"	off road - best way to WHITE OAK S S N	-X-X-X	"CC"
how at least four ties, also fence ad type of witness trees' and if rive at corner. 12."	off road - best way to WHITE OAK S S N	X-X-X WHITE	
how at least four ties, also fence ad type of witness trees' and if rive at corner. 12."	off road - best way to WHITE OAK S S N	28. 2 C."	_
how at least four ties, also fence ad type of witness trees' and if rive at corner. 12." CTH VENC OF 125, B SONE	off road - best way to WHITE OAK ST. S. X-X-3 N	28. 2 C."	NEW TIE '04
how at least four ties, also fence nd type of witness trees' and if rrive at corner. /2"	off road - best way to WHITE OAK S S N	28. 2 C."	_

MAINTENANCE RECORD

DATE	BY WHOM	REMARKS
5.76.8z	PK-55	6.K.
2-20-37	Š S	oK_
12-4-91	KE-SG	OR
2-17-97	J6-55	OK
1-14-02	J6=	0K
4-7-4	DLA-JLG	HAR REMOVED CONST. NEW TIES
02-28-12	MS	FO PK NAIL
		·
		<u> </u>

Government Land Corner Certificate	<u>_</u>
ADAMS County	CORNER NO. 117
TYPE OF MONUMENT: HARRISON - RR SPING PK	NAIL SECTION 36
STATE PLANE COORDINATES: N	TOWN
<u>E </u>	RANGE
ELEVATION — M.S.L. DATUM:THETA ANGLE:	
FIELD BOOK: 88 PAGE 66	
DRAWN BY: L. COOMBS	4
	=
BASIS FOR MONUMENT LOCATION	
Show info such as: History of corner, with reference to Vol. and pg., dates, surveyor; exact description of monument replaced; if location computed, by taped or EDM traverse; landowner remarks, etc. (Use reverse side if necessary)	LOCATION
landowner remarks, etc. (Use reverse side if necessary)	LOCATION (Indicated by 'X') SEAL:
No record of resurveys. Did not excavate since search area falls in ditch area. Corner	SEAL: ANTHONY B. KIEDROWSKI S-878 Wisconsin Rapids, Wis.
set on line and equidistant between Section corners.	1 Miles
	ANTHONY B. KIEDROWSKI
4-10-07 TIUS ARE OK - RR SPIKE SET	\$-31 S-878 \$
Auc '08	Wisconsin Rapids, Wis.
•	The state of the s
	SURVINI
	44444466
	DATA SHOWN HERE ON CERTIFIED CORRECT:
	Dythan & Kechens
	Registered Land Surgeyor
	DATE:10/7/81
LIE SKETCH	
Show at least four ties, also fence lines, roads, topo, size and type of witness trees' and if off road - hest way to	/ NEW TIE TO P.P.
rrive at corner. 12" WHITE OAK/_ V	Z NEW DISTANCE'S
	TO 6" WHITE PINE
Ø : 1 1 1 1 1 1 1 1 1 1 1 1 1 1 1 1 1 1	* ANWEOR POLE
332 24 S	HARRY REMOVED FOR
1 1 <i>i</i>	
× 5.12,	(-x-x' ROAD CONS.
- & - \ \ \ \ \ \ \ \ \ \ \ \ \ \ \ \ \	of OLA/JLG
	"""
1248	WINTE 4-7-04
DWER POLE	A
	POWER POLE
1957 P	P.K. NAIL
HAR	ry CEFT By TREE
0.44	TREE

`