34 SECTION

OT RANGE ADAMS COUNTY COUNTY CORNER NO: 118 ROMPORTOL ID: 41807342000

PUBLIC LAND SURVEY MONUMENT RECORD

HARRISON TYPE OF MONUMENT: ADAMS COUNTY COORDINATES, NAD 83 (2007)

N. **227170.899**

E. 578234.495


ELEVATION-DATUM - ---

02/06/2020 FIELD WORK DATE:

BASIS FOR MONUMENT LOCATION

1979 - PLS 1478 SET HARRISON MONUMENT ON STRAIGHT LINE BETWEEN SECTION CORNERS AND OPPOSITE FENCE LINES. THIS LOCATION APPEARS TO BE THE SAME AS INDICATED BY M.C. SMITH IN SURVEYS TO THE EAST. EXCAVATION WITH BACKHOE YIELDED NO EVIDENCE OF ANY PREVIOUS MONUMENTATION.

2020 - PLS 2675 FOUND A HARRISON MONUMENT 16" BELOW THE ROAD SURFACE AND DID NOT RECOVER ANY TIES OR WITNESSES. THE MONUMENT IS ON A NEAR STRAIGHT LINE BETWEEN THE NE AND SE CORNERS. ACCEPTED THE HARRISON MONUMENT AS THE BEST EVIDENCE OF THE CORNER LOCATION. SET 4 NEW TIES.

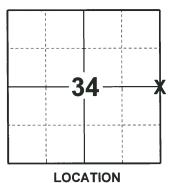

(INDICATE CORNER BY "X")



DATA SHOWN HERE ON THIS TIE SHEET IS CORRECT AND COMPLETE TO THE BEST OF MY KNOWLEDGE AND BELIEF.


PROFESSIONAL LAND SURVEYOR

2020

-TIE SKETCH

NOTE: THE CORNER LANDS ON THE CENTERLINE OF 3RD AVE.



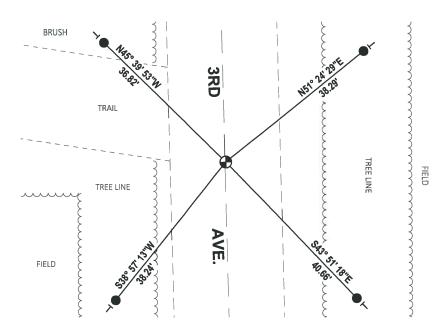

- SET 3/4" x 18" IRON REBAR, 1.50#/FT
- FOUND HARRISON MONUMENT
- VINYL "T" POST

ADAMS COUNTY

Survey Monument Record

TYPE OF MONUMENT: #ARCISON
STATE PLANE COORDINATES: N________
E

ELEVATION — M.S.L. DATUM: ______
THETA ANGLE: _____

*

CORNER NO.

/8

SECTION

TOWN

RANGE

BASIS FOR MONUMENT LOCATION

(Use reverse side if necessary)

Show info such as: History of corner, with reference to Vol. and pg, dates, surveyor; exact description of monument replaced; if location computed, by taped or EDM traverse; landowner remarks, etc.

Set monument on centerline and opposite fence lines.
This location appears to be the same as indicated by
M.C. Smith in surveys to the east.

Excavation with backhoe yielded no evidence of any previous monumentation.

GREGORY P.
RHINEHART
S-1478
Wisconsin Rapids
Wis.

CORNER OK 5-21-82 NORWAY GONE 4 THE REMAIN 12-2-91 55-5G OK 56-85 2-18-97 OK 1-03-02 GR OK 4-10-07 56 OK 03-18-12 MS-55

CERTIFIED CORRECT:


Registered Land Surveyor

DATE:

2/4/79

TIE SKETCH

(Show at least four ties)

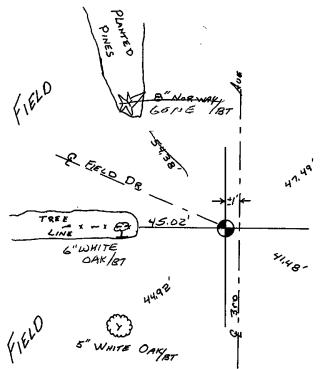

B" WHITE OAK/BT
MOST NORTHERLY
OF CLUSTER OF FOUR