OT RANGE ADAMS COUNTY COUNTY CORNER NO: 119 ROMPORTOL ID: 41807352000

PUBLIC LAND SURVEY MONUMENT RECORD

HARRISON TYPE OF MONUMENT: ADAMS COUNTY COORDINATES, NAD 83 (2007)

N. **227205.866**

E. 583516.124


DATUM - - --**ELEVATION-**

FIELD WORK DATE: 02/06/2020


BASIS FOR MONUMENT LOCATION

1981 - PLS 878 EXCAVATED 8'X10' HOLE, FOUND NOTHING. NO RECORD OF ANY REMONUMENTATION SUBSEQUENT TO THE ORIGINAL POST. CORNER IS SET HALF-WAY BETWEEN SECTION CORNERS BUT NOT ON A STRAIGHT LINE. THE EAST-WEST LOCATION BASED ON OCCUPATION OF SECTION 36.

2020 - PLS 2675 FOUND HARRISON MONUMENT 6"± BELOW THE ROAD SURFACE AND 1 WITNESS. THE MONUMENT AGREES WITH THE WITNESS. ACCEPTED THE HARRISON MONUMENT AS THE CORNER LOCATION. SET 4 NEW TIES AND MEASURED TO THE EXISTING WITNESS.

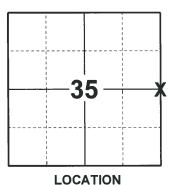

(INDICATE CORNER BY "X")

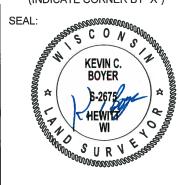

DATA SHOWN HERE ON THIS TIE SHEET IS CORRECT AND COMPLETE TO THE BEST OF MY KNOWLEDGE AND BELIEF.


PROFESSIONAL LAND SURVEYOR

-TIE SKETCH

NOTE: THE CORNER LANDS 1'± LANDS WEST OF THE CENTERLINE OF CTH "G".



- SET 3/4" x 18" IRON REBAR, 1.50#/FT
- FOUND HARRISON MONUMENT
- VINYL "T" POST
- MAGNAIL IN RR TIE FENCE CORNER

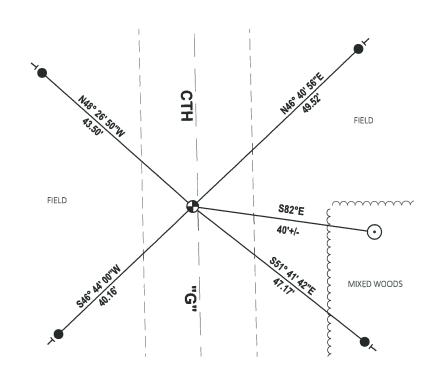

Government Land Corner Certificate		
ADAMSCounty	CORNER NO	
TYPE OF MONUMENT: HARRISON	SECTION _	36
STATE PLANE COORDINATES: N	TOWN _	
ELEVATION — M.S.L. DATUM:	RANGE _	
THETA ANGLE:		7
FIELD BOOK: 88 PAGE 65		- 4
DRAWN BY: L. COOMBS	* + +	- NI
BASIS FOR MONUMENT LOCATION		IN
Show info such as: History of corner with reference to Vol		İ
and pg., dates, surveyor; exact description of monument replaced; if location computed, by taped or EDM traverse; landowner remarks, etc. (Use reverse side if necessary)	LOCATION	٦.
landowner remarks, etc. (Use reverse side if necessary)	SEAL: (Indicated by X')	÷
Excavated 8'x10' hole, found nothing. No record	WALL CONTRACTOR	o.
of any remonumentation subsequent to the original	RIVINGCONS!	And the second
post. Corner is set half-way between Section corners but not on a straight line. The East-	ANTHONY B.	
West location based on occupation of Section 36.	KIEDROWSKI S-878	₩
	S-878 Wisconsin Rapids, Wis.	C S
	A A	A CHILLIAN THE STREET STREET
	SURVIN	
	DATA CHOUNT HERE ON	
	DATA SHOWN HERE ON CERTIFIED CORRECT:	
	Registered Land Surveyor	enned
	DATE: 10/7/81	
	DATE: 20/1/01	
TIE SKETCH		
Show at least four ties, also fence lines, roads, topo, size and type of witness trees' and if off road - best way to arrive at corner.		
BLUE KIEL ON 9		
OF CULVERT.		
ر الربا عن ا		
8 5 3	9.50	
MAG NA!	L IN ARTIE FENCE GR	
	- X - X	
SOUTHEAST CORNER RIW POST	. M. N ew	MATL
1/2	163 8 NORW	DAY PINE/BT
	6.9' 51 6"NORWAY 12	
1 4 30	TO G" NORWAY	-PINE/_
	MAN "GONE"	· ··· ~ 1157
	2-10" WHITE	PINESTA
CT+H	V	
1 1		

MAINTENANCE RECORD

DATE	BY WHOM	REMARKS	
5-24-82	PK-55	O.K.	
4-6-87	6R - 55	O/L	
12-4-91	KZ -36	OK	
2-17-97	JC-55	OK	
1-14-02	JG	1-GONE, 1-NEW, CORNER OK Z-TIES LEFT, NOTHING AVAILABLE	
4-10-07	JE	Z-TIES LEFT, NOTHING AVAILABLE	
02-27-12	M5-55	2 NEW TIES	
		·	
		· · ·	
	·	` ` · · · · · · · · · · · · · · · · · ·	