33 SECTION

OT ADAMS COUNTY

COUNTY CORNER NO: 127 ROMPORTOL ID: 41807330000

PUBLIC LAND SURVEY MONUMENT RECORD

TYPE OF MONUMENT:	HARRISON (BROKEN-TOP)		
ADAMS COUNTY COORDINATES, NAD 83 (2007)			
N. 224516.072	2		


ELEVATION-DATUM 01/09/2018 FIELD WORK DATE:

BASIS FOR MONUMENT LOCATION


E. 572968.753

1979 - PLS 1478 SET CORNER AT THE CENTERLINE INTERSECTION OF EXISTING ROADS. EXCAVATION WITH A BACKHOE AT THIS LOCATION YIELDED NO EVIDENCE OF ANY PREVIOUS MONUMENTATION. THIS LOCATION FITS THE SECTION VERY WELL. SET A HARRISON MONUMENT AT THE CORNER LOCATION AND TIED OUT.

2017 - PLS 2994 FOUND A HARRISON MONUMENT WITH A BROKEN-TOP 18" BELOW THE ROAD SURFACE AND 2 RIGHT OF WAY IRONS WITH GUARD POSTS. FOUND NO EVIDENCE OF ANY TIES OR WITNESSES. ACCEPTED THE HARRISON MONUMENT WITH A BROKEN-TOP AS THE BEST EVIDENCE OF THE CORNER LOCATION. SET 2 NEW TIES AND MEASURED TO THE RIGHT OF WAY IRONS AND TIES.

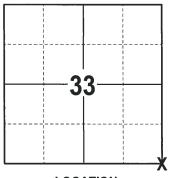

LOCATION (INDICATE CORNER BY "X")

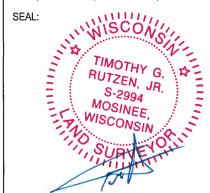

DATA SHOWN HERE ON THIS TIE SHEET IS CORRECT AND COMPLETE TO THE BEST OF MY KNOWLEDGE AND BELIEF.

PROFESSIONAL LAND SURVEYOR

2-2-18

- TIE SKETCH


NOTE: THE CORNER FALLS 2'± SOUTH OF THE CENTERLINE OF CTH J.



- 3/4" x 18" IRON REBAR SET, 1.50#/FT 5/8" IRON ROD FOUND
- 🕀 HARRISON (BROKEN-TOP) FOUND

→ VINYL "T" POST

■ RW GUARD POST

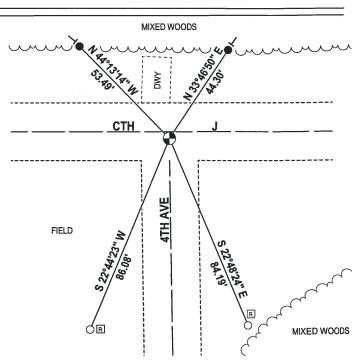

Government Land Corner Certificate CORNER NO. __/27 County **SECTION** TYPE OF MONUMENT: 1-JARRISON **TOWN** STATE PLANE COORDINATES: **RANGE** E. ELEVATION — M.S.L. DATUM: ___ THETA ANGLE: ___ FIELD BOOK: _____77 _ PAGE _ <u>46</u> DRAWN BY: R. NUBER BASIS FOR MONUMENT LOCATION Show info such as: History of corner, with reference to Vol. and pg., dates, surveyor; exact description of monument replaced; if location computed, by taped or EDM traverse; landowner remarks, etc. (Use reverse side if necessary) SEAL: Set corner at the centerlines of existing roads. excavation with backhoe at this location yielded no evidence of any previous monumentation. this location' "fits" the section very well. DATE: TIE SKETCH Show at least four ties, also fence lines, roads, topo, size and type of witness trees' and if off road - best way to arrive at corner.

FIRST CASS
GAS LINE
WARNING SIEN 1

LONE FENCE POST

GONE 97'

CONE 97'

CON

MAINTENANCE RECORD

DATE	BY WHOM	REMARKS
3-26-82	GR-55	O.K.
Z-18-87	SS	O.K.
1-10-92	56	0.k.
2-18-97	J&-55	1-60NE, 4-LEFT COR OK
4-10-07		/ NEW TIE
4-10-07	To	1-GONE, 4 LEFT COR OR 1 NEW TIES OK
		·
		X.i.
The same of the sa) .	
	·	