OT ADAMS COUNTY

COUNTY CORNER NO: 129

ROMPORTOL ID: 41807340000

PUBLIC LAND SURVEY MONUMENT RECORD

TYPE OF MONUMENT:	HARRISON (BROKEN-TOP)	
ADAMS COUNTY COORDINATES, NAD 83 (2007)		
N. 224535.758		

ELEVATION-DATUM


01/10/2018 FIELD WORK DATE:

E. 578258.592

BASIS FOR MONUMENT LOCATION

1979 - PLS 1478 THE INTERSECTION OF CENTERLINES SEEMS TO BE THE SPOT ACCEPTED BY M.C. SMITH AS FILED IN VOL. 2 PG. 60 ADAMS CO. SURVEYOR'S RECORDS AND IT ALSO FITS THE SECTION VERY WELL. EXCAVATION WITH A BACKHOE YIELDED NO EVIDENCE OF ANY PREVIOUS MONUMENTATION. SET HARRISON AND TIED OUT.

2017 - PLS 2994 FOUND A HARRISON MONUMENT WITH A BROKEN-TOP 18" BELOW THE ROAD SURFACE AND 4 RIGHT OF WAY IRONS WITH GUARD POSTS. FOUND NO EVIDENCE OF ANY TIES OR WITNESSES. ACCEPTED THE HARRISON MONUMENT WITH A BROKEN-TOP AS THE BEST EVIDENCE OF THE CORNER LOCATION. MEASURED TO THE 4 RIGHT OF WAY IRONS TO BE USED

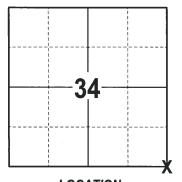

LOCATION (INDICATE CORNER BY "X")

SEAL: HISCON TIMOTHY G. RUTZEN, JR. S-2994 MOSINEE WISCONSI

DATA SHOWN HERE ON THIS TIE SHEET IS CORRECT AND COMPLETE TO THE BEST OF MY KNOWLEDGE AND BELIEF.

PROFESSIONAL LAND SURVEYOR


2-2-18 DATE

- TIE SKETCH


NOTE: THE CORNER FALLS 1'± SOUTH OF THE CENTERLINE OF CTH J AND 1'± WEST OF THE CENTERLINE OF 3RD AVE.



○ 5/8" IRON ROD FOUND HARRISON (BROKEN-TOP) FOUND RW GUARD POST

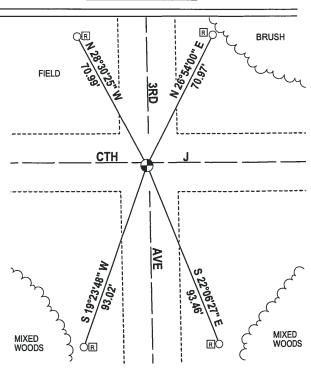

Government Land Corner Certificate CORNER NO. Adams $_$ County SECTION Harrison TYPE OF MONUMENT: _ TOWN STATE PLANE COORDINATES: RANGE ELEVATION - M.S.L. DATUM: _ THETA ANGLE: PAGE 101 FIELD BOOK: _ DRAWN BY: N. J. BASIS FOR MONUMENT LOCATION Show info such as: History of corner, with reference to Vol. and pg., dates, surveyor; exact description of monument replaced; if location computed, by taped or EDM traverse; landowner remarks, etc. (Use reverse side if necessary) LOCATION (Indicated by 'X') GREGORY P. RHINEHART S-1478 Wisconsin Rapids Wis. SEAL: Set monument at the intersection of centerlines. this location seems to be the spot accepted by M.C. Smith as filed in Vol. 2 Pg. 60 Adams co. Surveyor's Records and also "fits" the section very well. Excavation with backhoe yielded no evidence of any previous monumentation. DATA SHOWN HERE ON CERTIFIED CORRECT: Registered Land Surveyor 10 -11-79 DATE: TIE SKETCH

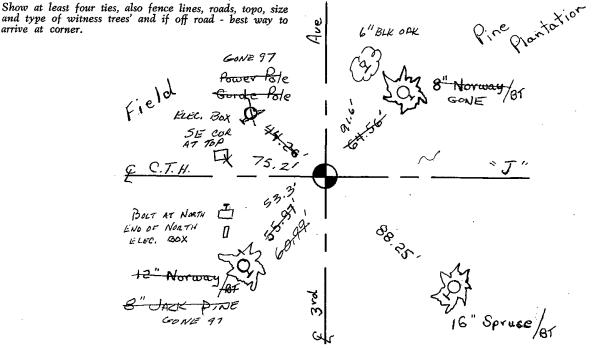

arrive at corner.

MAINTENANCE RECORD

DATE	BY WHOM	REMARKS
3-26-82	GR-55	0. K.
4-6-87	GR-55	OK I NEW TIE
12-4-91	KZ-JG	1-GONE OK 2-GONE, 2-NEW, COR OK
2-18-97	JG -5S	2-GONE, 2-NEW, COR OK
1-09-02	56-95	OK
4-10-07	JG	OK
•		
		,
		·