OT ADAMS COUNTY

COUNTY CORNER NO: 130 ROMPORTOL ID: 41807350020

PUBLIC LAND SURVEY MONUMENT RECORD

TYPE OF MONUMENT:	HARRISON (BROKEN-TOP)
ADAMS COUNTY COORDINATES,	NAD 83 (2007)
N. 224552.213	

DATUM


01/10/2018 FIELD WORK DATE:

E. 580902.717


BASIS FOR MONUMENT LOCATION

1979 - PLS 1478 CALCULATED SEARCH LOCATION ON A LINE BETWEEN ADJACENT SECTION CORNERS AND OPPOSITE OF POSSESSION LINE TO THE SOUTH. THIS LOCATION BEST FITS POSSESSION THROUGHOUT THE SECTION. EXCAVATION WITH A BACKHOE YIELDED NO EVIDENCE OF ANY MONUMENTATION. SET A HARRISON AT CALCULATED POSITION AND TIED OUT.

2017 - PLS 2994 FOUND A HARRISON MONUMENT WITH A BROKEN-TOP 18" BELOW THE ROAD SURFACE, 1 TIE AND 1 RIGHT OF WAY IRON WITH GUARD POST. THE MONUMENT AGREES WITH THE EXISTING TIE. ACCEPTED THE HARRISON MONUMENT WITH A BROKEN-TOP AS THE CORNER LOCATION. SET 2 NEW TIES AND MEASURED TO THE

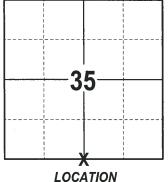

(INDICATE CORNER BY "X")

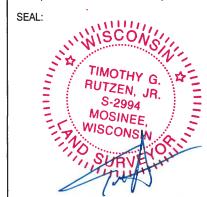

DATA SHOWN HERE ON THIS TIE SHEET IS CORRECT AND COMPLETE TO THE BEST OF MY KNOWLEDGE AND BELIEF.

PROFESSIONAL LAND SURVEYOR


- TIE SKETCH

NOTE: THE CORNER FALLS 3'± SOUTH OF THE CENTERLINE OF CTH J.



3/4" x 18" IRON REBAR SET, 1.50#/FT 3/4" IRON ROD FOUND 🕀 HARRISON (BROKEN-TOP) FOUND

RW GUARD POST → VINYL "T" POST

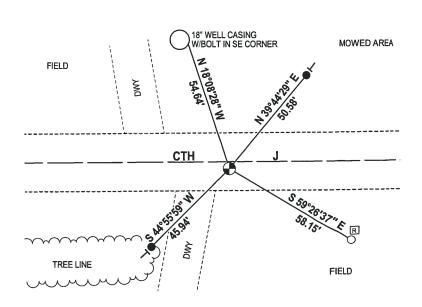

Government Land Corner Certificate		
Adams County	CORNER NO	130
TYPE OF MONUMENT: Harrison	SECTION .	35
STATE PLANE COORDINATES: N	TOWN	18
Е	RANGE	
ELEVATION — M.S.L. DATUM:	<u> </u>	- 7
THETA ANGLE:		
DRAWN BY: NJ		
BASIS FOR MONUMENT LOCATION		:
Show info such as: History of corner, with reference to Vol.		İ
and pg., dates, surveyor, exact description of monument replaced; if location computed, by taped or EDM traverse; landowner remarks, etc. (Use reverse side if necessary)	LOCATION	
(Use reverse sine if necessary)	SEAL: (Indicated by 'X')	
	Renting COVO	.
Set monument on line between adjacent section	GREGORY P. RHINEHART S-1478 Wisconsin Rapids Wis.	ANNUM CARROLL CONTROLL CONTROL CONTR
corners - opposite possesion line to the south. this location best fits possesion throughout the	GREGORY P.	\ <u>\</u>
section. excavation with backhoe vielded no	RHINEHART S-1478	
evidence of any monumentation.	Wisconsin Rapids Wis.	
		<
6	7 / /	War.
	SURVE SURVE	
	DATA SHOWN HERE ON	
igwedge	CERTIFIED CORRECT:	0 ~4
	Registered Land Surveyor	<u>ahaid</u>
	DATE: _/0-//-79	<u> </u>
TIE SKETCH /		·
Show at least four ties also fonce lines roads tone sing		
and type of witness trees' and if off road - best way to arrive at corner.	(1)	
Bolt) at SE	PK-NAIL TOP OF STUM	
Field Cor of well - {	18" Bur Oak	r
A, Cal	9 }} / ⁸¹	
34' ±		
CCTH.	<u>*</u> *	٠.,
	·	
←10,∓→ ½"		•
NE COR	**************************************	
AT BOTTOM	•	
Lie Buer	- X CONE 97	
O A!	V	
	Field	
	ciela.	
/ F / /	γ,	

MAINTENANCE RECORD

DATE	BY WHOM	REMARKS
3-26-82	6R-S5	0.K.
4-6-87	GR- 55	. OK
12-4-91	KZ-56	o k
2-18-97	JG- 55	2-60NB, 2-NBW, CON OK
	76-55	2 TIES REMAIN - NOTHING AVAILAS
1-09-02 4-10-07	Je	П 11 4
· · ·		
		
<u></u>		

94: 33: 1