ADAMS COUNTY COUNTY CORNER NO: 92

ROMPORTOL ID: 41904240020

PUBLIC LAND SURVEY MONUMENT RECORD

HARRISON TYPE OF MONUMENT: ADAMS COUNTY COORDINATES, NAD 83 (2007)

N. 266384.042

E. 492061.809


ELEVATION-DATUM

03/19/2019 FIELD WORK DATE:


BASIS FOR MONUMENT LOCATION

1982 - PLS 878 NO RECORDS OF ANY RESURVEYS. THIS CORNER IS SET ON A STRAIGHT LINE AND EQUIDISTANT BETWEEN THE MONUMENT AT THE SE CORNER OF THIS SECTION AND THE SW CORNER OF THIS SECTION. THE THEORETICAL SW CORNER WAS SET AS FOLLOWS: THE NORTH LINE OF THE NE1/4 OF THIS SECTION WAS EXTENDED AND DOUBLED TO THE WEST TO ESTABLISH THE NW CORNER OF THIS SECTION. THE LINE AND DISTANCE FROM THE THEORETICAL NW CORNER TO THE W1/4 CORNER WAS DOUBLED AND EXTENDED SOUTH TO ESTABLISH THE THEORETICAL SW CORNER OF THIS SECTION. THIS GIVES US DIMENSIONS ALL THE WAY AROUND TRHE SECTION WHICH QUITE COMPATIBLE WITH THE ORIGINAL GOVERNMENT SURVEY NOTES.

2019 - PLS 2675 FOUND HARRISON FLUSH WITH THE GROUND SURFACE AND 4 WITNESSES. THE MONUMENT AGREES WITH ALL WITNESSES. ACCEPTED HARRISON AS THE CORNER LOCATION. SET 4 NEW TIES AND MEASURED TO EXISTING WITNESSES.

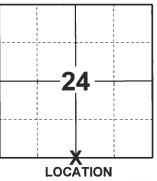

(INDICATE CORNER BY "X")

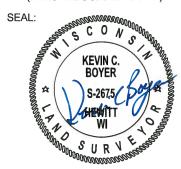

DATA SHOWN HERE ON THIS TIE SHEET IS CORRECT AND COMPLETE TO THE BEST OF MY KNOWLEDGE AND BELIEF.

PROFESSIONAL LAND SURVEYOR

DATE

-TIE SKETCH




SET 3/4" x 18" IRON REBAR, 1.50#/FT

FOUND HARRISON MONUMENT

VINYL "T" POST

WITNESS TREE

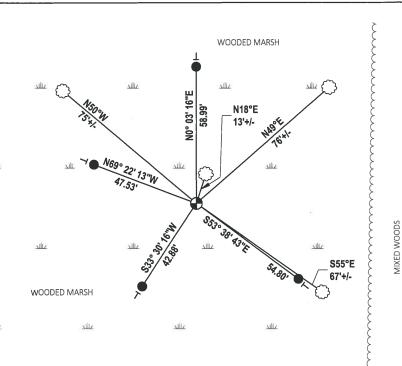

Government Land Corner Certificate

ADAMS	County	
TYPE OF MONUMENT:	HARRISON	
STATE PLANE COORDINATES	S: N	
	<u> </u>	
ELEVATION — M.S.L. DATU	IM:	
THETA ANGLE:		<u>_</u>
FIELD BOOK:	PAGE	
DRAWN BY: ROBERT	T. WELCH	

BASIS FOR MONUMENT LOCATION

Show info such as: History of corner, with reference to Vol. and pg., dates, surveyor; exact description of monument replaced; if location computed, by taped or EDM traverse; landowner remarks, etc. (Use reverse side if necessary)

No record of any resurveys. This corner is set on a straight line and equidistant between the monument at the SE corner of this Section and the SW corner of this Section.

The theoretical, corner was set as follows:


The North line of the NE½ of this Section was extended and doubled to the West to establish the NW corner of this Section. The line and distance from the theoretical NW corner to the W½ corner was doubled and extended South to establish the theoretical SW corner of this Section. This gives us dimensions all the way around the Section which aimse quite compatible with the original government survey notes.

 CORNER NO.
 92

 SECTION
 24


 TOWN
 /9

 RANGE
 4

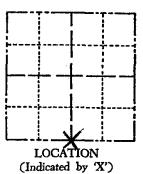

4 N


SEAL:

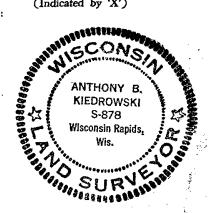

DATA SHOWN HERE ON CERTIFIED CORRECT:

Arkan, Black Strong

DATE: 3-5-82

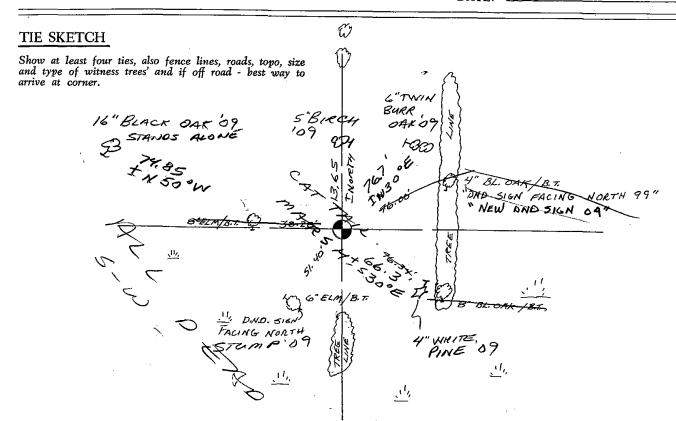

MAINTENANCE RECORD

DATE	BY WHOM	REMARKS
1-9.89	6R-KZ	OK.
2-21-94	J(3-6R	OK
1-26-99	JG	OK .
1-5-04	JG	OK
2-24-09	55	MON OK - 4 NEW TIES
<i>*.</i>		
	·	
` 		
·		