SECTION

## OS ADAMS COUNTY

COUNTY CORNER NO: 126

ROMPORTOL ID: 42005330020


## PUBLIC LAND SURVEY MONUMENT RECORD

HARRISON (BROKEN-TOP) TYPE OF MONUMENT: ADAMS COUNTY COORDINATES, NAD 83 (2007) N. **287509.111** E. 507086.736 DATUM - - -**ELEVATION-**02/08/2018 FIELD WORK DATE:


## BASIS FOR MONUMENT LOCATION

1980 - PLS 1478 STATES HE SET CORNER FROM THE ROTTED STUMP OF A BLACK OAK BEARING TREE BY M.C. SMITH AS RECORDED IN THE ADAMS COUNTY SURVEYOR RECORDS V. 2, P. 48. THIS FIT EXTREMELY WELL WITH THE STONE FOUND BY A.B. KIEDROWSKI AT THE NE CORNER OF SECTION 4. IT ALSO FIT WELL WITH THE 2" IRON PIPE AT THE NW CORNER OF THE NE1/4 OF THE NW1/4 REFERENCED BY ADAMS COUNTY CERTIFIED SURVEY MAP BY EDMOND NOVAK RLS 561, NO EXCAVATION WAS MADE AT THIS POINT AS THE CORNER FALLS IN THE BOTTOM OF THE NORTH DITCH OF BADGER AVENUE. THIS CORNER DOES NOT FALL ON THE EAST LINE OF PETENWELL HIGHLANDS IN THE NE1/4 OF THE NW1/4. THERE IS NO MENTION OF ANY CORNER USED AT THE N1/4 CORNER FOR THIS PLAT. SET HARRISON AT CALCULATED LOCATION AND

2018 - PLS 2994 FOUND A HARRISON MONUMENT WITH A BROKEN-TOP 30" BELOW THE ROAD SURFACE, 1 TIE AND 1 PROPERTY IRON, THE MONUMENT AGREES WITH THE EXISTING TIE. ACCEPTED THE HARRISON MONUMENT WITH A BROKEN-TOP AS THE CORNER LOCATION. SET 2 NEW TIES AND MEASURED TO THE TIES AND PROPERTY IRON.

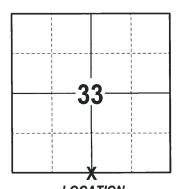

LOCATION (INDICATE CORNER BY "X")

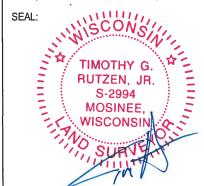

DATA SHOWN HERE ON THIS TIE SHEET IS CORRECT AND COMPLETE TO THE BEST OF MY KNOWLEDGE AND BELIEF.


PROFESSIONAL LAND SURVEYOR

3-1-18

- TIE SKETCH



- 3/4" x 18" IRON REBAR SET, 1.50#/FT
- 3/4" IRON ROD FOUND
- 2-3/8" O.D. IRON PIPE FOUND
- 🕀 HARRISON (BROKEN-TOP) FOUND
- ✓ STEEL FENCE POST
- → VINYL "T" POST

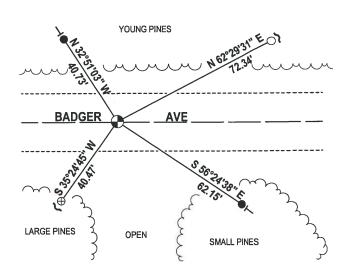

Adams Country	CORNER NO.	6
TYPE OF MONUMENT: Harrison	SECTION .	<del></del>
STATE PLANE COORDINATES: N	TOWN .	19
E	RANGE	
ELEVATION — M.S.L. DATUM:	r <del></del>	<b>-</b> -
THETA ANGLE:		
FIELD BOOK: 78 PAGE /30	; <u>;</u>	
DRAWN BY: G. Phinehart	<b></b>	
		IN
BASIS FOR MONUMENT LOCATION		·
Show info such as: History of corner, with reference to Vol.	<u> </u>	
and pg., dates, surveyor; exact description of monument replaced; if location computed, by taped or EDM traverse; andowner remarks, etc. (Use reverse side if necessary)	LOCATION	
et corner from the rotted stump of a black oak bearing SEAL:	(Indicated by 'X')	
ree by M. C. Smith as recorded in Adams County Sur-	Manney Committee	•.
eyor Records V. 2, p. 48. This fit extremely well ith the stone found by A. B. Kiedrowski at the NE	MINISCONS	10/1/2
orner of Section 4. It also fit well with the 2"	GREGORY P. RHINEHART S-1478 Wisconsin Rapids Wis.	THE THE PERSON NAMED IN TH
ron pipe at the NW corner of the NE4 of the NW4	GREGORY P. RHINEHART	/ <sup>22</sup> [
eferenced by Adams County Certified Survey Map by dmond Novak RLS 561. No excavation was made at this	S-1478 Wisconsin Rapids	
oint as the corner falls in the bottom of the north	Wis.	
itch of Badger Avenue. This corner does not fall on	a street	of s
he east line of Petenwell Highlands in the NE¼ of the NW¼. There is no mention of any corner used at	AND SURVE	iles.
the N½ corner for this plat.	A111815688888	<i>.</i>
	SHOWN HERE ON IED CORRECT:	
K 4-12-84   DK-SS   CERTIF		1 7
	i Aand Surveyor	
OK, 2-8-99-JG-55	April 4, 1980	
2-GONE, 2-NEW, 1-15-04 JG-JS DATE:		
TIE SKETCH	7 4	
Show at least four ties, also fence lines, roads, topo, size	5" BINE	Oak
and type of witness trees' and if off road - best way to		181
8" BLK DAK/BLAZED		
E CO	Á	PEDINGED WILL
		REPLACED WITH
6 Vack Pine 187		Pipe in
3990-	a0	$\bigcirc$
	42.90	M.C. Smith
<del></del>	<u> </u>	8.T. Stump
41		
Ø		
<del>\</del>		Badger
200'± TO 17th DR		Avenue
$\chi_0$   $S_{\nu}$	Z" Tack D	.)
E ITON 1 THE	Z"JACK A BLAZED (IN CLUST	NC
Northeast Corner Peterwell Hieghts	(IN CLUS	TER)
Subdivision	32.44	<del>/</del>

## MAINTENANCE RECORD

DATE	BY WHOM	REMARKS
<u> </u>		·
	1	
	<u> </u>	·
	<u> </u>	