OS ADAMS COUNTY

COUNTY CORNER NO: 127

ROMPORTOL ID: 42005330000


PUBLIC LAND SURVEY MONUMENT RECORD

HARRISON TYPE OF MONUMENT: ADAMS COUNTY COORDINATES, NAD 83 (2007) N. **287521.940** E. 509722.715 DATUM FIELD WORK DATE: 02/08/2018


BASIS FOR MONUMENT LOCATION

1973 - PLS 878 THE APPROXIMATE LOCATION OF THIS CORNER WAS POINTED OUT TO ME BY W.M. KIEFER, AREA RESIDENT AND COUNTY BOARD CHAIRMAN. EXCAVATION WITH A BACKHOE EXPOSED A STONE. THE STONE WAS LOWERED AND A HARRISON MONUMENT WAS SET ON TOP AND THE CORNER WAS TIED OUT.

2018 - PLS 2994 FOUND A HARRISON MONUMENT 24" BELOW THE ROAD SURFACE AND 1 TIE. THE MONUMENT AGREES WITH THE EXISTING TIE. ACCEPTED THE HARRISON MONUMENT AS THE CORNER LOCATION. SET 3 NEW TIES AND MEASURED TO THE TIES.

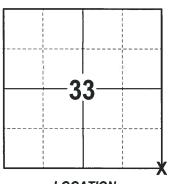

LOCATION (INDICATE CORNER BY "X")

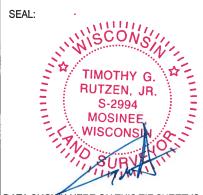

DATA SHOWN HERE ON THIS TIE SHEET IS CORRECT AND COMPLETE TO THE BEST OF MY KNOWLEDGE AND BELIEF.


PROFESSIONAL LAND SURVEYOR

- TIE SKETCH

NOTE: THE CORNER FALLS 4'± SOUTH OF THE CENTERLINE OF BADGER AVE.



 3/4" x 18" IRON REBAR SET, 1.50#/FT 1" IRON ROD FOUND HARRISON FOUND FIRE SIGN #7101 STEEL FENCE POST → VINYL "T" POST

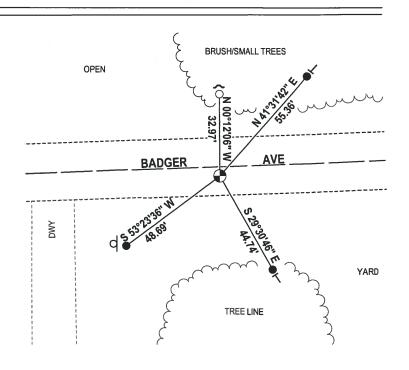

ADAMS COUNTY CORNER NO. . SECTION Survey Monument Record TOWN Harrison std. TYPE OF MONUMENT: __ سی RANGE STATE PLANE COORDINATES: N. ELEVATION — M.S.L. DATUM: THETA ANGLE: . FIELD BOOK: _108 PAGE __39 BASIS FOR MONUMENT LOCATION (Use reverse side if necessary) Show info such as: History of corner, with reference to Vol. and pg, dates, surveyor; exact description of monument replaced; if location computed, by taped or EDM traverse; landowner SEAL: Approximate location of this corner pointed out to me by Wm Kiefer, area resident and County Board Chairman. Excavattion with a backhoe exposed a stone. See picture attached. Stone was lowered and a Harrison set on top. Iron pipe shown in picture was set along stone at one time, according to Mr. Kiewfer, and had been pan pulled out by grader. CR-JG RN-55 OK CERTIFIED CORRECT: 2-8-99 OK 1-15-04 TIE SKETCH (Show at least four ties) Ties to nail and disc. Roo (1) 34 IRON ROP csm msa STEEL BUILDING 6"NORWA PING

REVISED 1972

· ·

• •