05 ADAMS COUNTY COUNTY CORNER NO: 16A ROMPORTOL ID: 41905052000A

PUBLIC LAND SURVEY MONUMENT RECORD

TYPE OF MONUMENT: 2-3/8" O.D. IRON PIPE W/ALUMINUM CAP ADAMS COUNTY COORDINATES, NAD 83 (1905)

N. 286611.119

E. 504448.078


ELEVATION-DATUM - ----

10/07/2019 FIELD WORK DATE:_


BASIS FOR MONUMENT LOCATION

1983 - PLS 1444 THIS MEANDER CORNER CORNER WAS SET BY USING A SECTION SUMMARY PROVIDED BY KEN CARLSON AND EXTENDING THE LINE NORTH TO THE WATERS EDGE.

2019 - PLS 2675 FOUND 2-3/8" O.D. IRON PIPE WITH ALUMINUM CAP 3"± BELOW THE GROUND, 1 TIE AND 2 WITNESSES. THE TIE HAS BEEN DISTURBED BUT THE MONUMENT AGREES WITH BOTH WITNESSES. ACCEPTED THE 2-3/8" O.D. IRON PIPE WITH ALUMINUM CAP AS THE CORNER LOCATION. SET 4 NEW TIES AND MEASURED. TO THE EXISTING TIE AND WITNESSES.

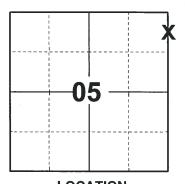

LOCATION

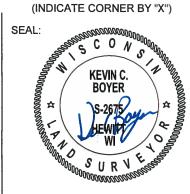


DATA SHOWN HERE ON THIS TIE SHEET IS CORRECT AND COMPLETE TO THE BEST OF MY KNOWLEDGE AND BELIEF.

PROFESSIONAL LAND SURVEYOR

-TIE SKETCH

NOTE: TIES SET 2'± OFF BUILDING CORNERS, UNDERGROUND 4"±



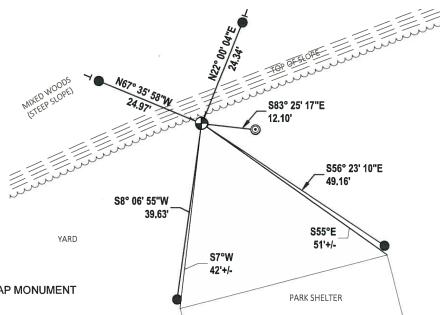

- SET 3/4" x 18" IRON REBAR, 1.50#/FT
- FOUND 2-3/8" O.D. IRON PIPE
- FOUND 2-3/8" O.D. IRON PIPE WITH ALUM. CAP MONUMENT
- VINYL "T" POST