TOWN

ADAMS COUNTY CORNER NO: 17

ROMPORTOL ID: 41905042000

PUBLIC LAND SURVEY MONUMENT RECORD

HARRISON (BROKEN-TOP) TYPE OF MONUMENT: ADAMS COUNTY COORDINATES, NAD 83 (1905)

N. 284869.127

E. 509697.386

ELEVATION-DATUM


11/21/2019 FIELD WORK DATE:

BASIS FOR MONUMENT LOCATION

1977 - PLS 1267 TRAVERSE SECTION BY EDM/T2. SET CORNER ON LINE AND PRORATED AS PER M.C. SMITHS NOTES. FOUND NO EVIDENCE OF M.C. SMITHS BEARING TREES AS PER HIS SURVEY MARCH 28, 1918.

1981 - PLS 1267 NOTE: HARRISON WAS SET IN ERROR FROM COMPUTATIONS FROM SECTION PROTRACTION BY EDM/T2 IN 1977; RESET HARRISON ON A STRAIGHT LINE AND PRORATION FROM M.C. SMITH'S DISTANCES. IN RESETTING HARRISON, WE FOUND EVIDENCE OF CHARCOAL PIECES AND DISCOLORATION OF THE SOIL AT CORNER LOCATION. JIM LOWREY IN RECENT SURVEY VERIFIES PROPER LOCATION OF HARRISON OF HARRISON AS RESET.

2019 - PLS 2675 FOUND HARRISON (BROKEN-TOP) 6"± BELOW THE GROUND, DID NOT RECOVER ANY EXISTING TIES OR WITNESSES DUE TO RECENT ROAD CONSTRUCTION AND UTILITY WORK. CHECKED IF THE HARRISON (BROKEN-TOP) WAS ON LINE AND EQUIDISTANT BETWEEN THE SECTION CORNER TO THE NORTH AND SOUTH. THE HARRISON (BROKEN-TOP) MONUMENT WAS 7'± SOUTH AND 0.5'± WEST FROM BEING ON LINE AND EQUIDISTANT. THE DISTANCE TO THE NORTH FITS WITH CSM 3436, AND 3437. THE DISTANCE TO THE SOUTH FITS WITH CSM 3891. ACCEPTED THE HARRISON (BROKEN-TOP) AS THE BEST EVIDANCE OF THE CORNER LOCATION, SET 4 NEW TIES AND MEASURED TO A FOUND 3/4" IRON ROD.

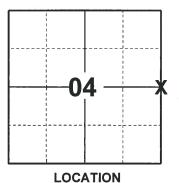

(INDICATE CORNER BY "X")



DATA SHOWN HERE ON THIS TIE SHEET IS CORRECT AND COMPLETE TO THE BEST OF MY KNOWLEDGE AND BELIEF.


PROFESSIONAL LAND SURVEYOR

DATE

-TIE SKETCH

NOTE: THE CORNER FALLS 49.6'± WEST OF CTH 'Z' CENTERLINE.



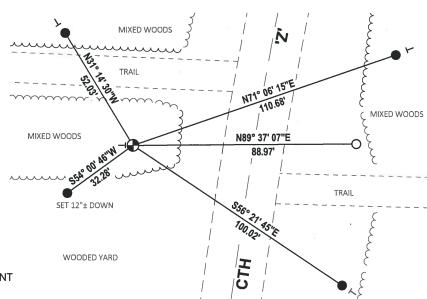

- SET 3/4" x 18" IRON REBAR, 1.50#/FT
- FOUND 3/4" IRON ROD
- FOUND HARRISON (BROKEN-TOP) MONUMENT
- VINYL "T" POST

Government Land Corner Certificate	CORNER NO.
AdmsCounty	SECTION 4
TYPE OF MONUMENT: 30" STANDARD HARLISON	10
TATE PLANE COORDINATES: N	TOWN
. E	RANGE
ELEVATION — M.S.L. DATUM:	
THETA ANGLE:	
FIELD BOOK: PAGE	
DRAWN BY:	
BASIS FOR MONUMENT LOCATION	
Show info such as: History of corner, with reference to Vol.	
ind no dates surveyor exact description of monument	<u> </u>
eplaced; if location computed, by taped or EDM traverse; andowner remarks, etc. (Use reverse side if necessary)	LOCATION (Indicated by 'X')
ote: Harrisin was set in error from	SEAL:
omputations from Section protraction by Edm &	Market CON -
-2 in 1977; reset Harrisin on a straight line and	WISCONS!
roration from M.C. Smith's distances. In	KENNETH H.
esetting Harrisin, we found evidence of charcoal	SCHUETTE SCHUETTE
eices and discoloration of the soil at corner	\$\frac{1}{2}\$ \$-1267 \$\frac{1}{2}\$
ocation. Jim Lowrey in recent survey verifies	mining
	BARABOO,
roper location of Harrisin as reset.	BARABOU, WIS.
	Wis.
	Wis.
	SURVE STATE OF THE
	DATA SHOWN HERE ON
	SURVE SURVE
	DATA SHOWN HERE ON CERTIFIED CORRECT:
	DATA SHOWN HERE ON
	DATA SHOWN HERE ON CERTIFIED CORRECT:
roper location of Harrisin as reset.	DATA SHOWN HERE ON CERTIFIED CORRECT: Len Surveyor Registered Land Surveyor DATE: 3 Mach 198/
	DATA SHOWN HERE ON CERTIFIED CORRECT: Len Schuetto Registered Land Surveyor DATE: 3 Mach 198/
roper location of Harrisin as reset. FIE SKETCH TIE SKETCH	DATA SHOWN HERE ON CERTIFIED CORRECT: Len Schuetto Registered Land Surveyor DATE: 3 Mach 198/
roper location of Harrisin as reset. FIE SKETCH Thow at least four ties, also fence lines, roads, topo, size and type of witness trees' and if off road - best way to	DATA SHOWN HERE ON CERTIFIED CORRECT: Len Schuetto Registered Land Surveyor DATE: 3 Mach 198/
TIE SKETCH Thow at least four ties, also fence lines, roads, topo, size and type of witness trees' and if off road - best way to rrive at corner.	DATA SHOWN HERE ON CERTIFIED CORRECT: Registered Land Surveyor DATE: DATE: Data 198 19
TIE SKETCH Show at least four ties, also fence lines, roads, topo, size and type of witness trees' and if off road - best way to wrive at corner. SEE CSM 4447	DATA SHOWN HERE ON CERTIFIED CORRECT: Len Schuetto Registered Land Surveyor DATE: 3 Mach 198/
TIE SKETCH Show at least four ties, also fence lines, roads, topo, size and type of witness trees' and if off road - best way to rrive at corner. SEE CSM 4447 1/4"Roo 15.16 EAST CSM 3437	DATA SHOWN HERE ON CERTIFIED CORRECT: Registered Land Surveyor DATE: DATE: Data 198 19
TIE SKETCH Show at least four ties, also fence lines, roads, topo, size and type of witness trees' and if off road - best way to rrive at corner. SEE CSM 4447 1/4"Roo 15.16 EAST CSM 3437	DATA SHOWN HERE ON CERTIFIED CORRECT: Registered Land Surveyor DATE:
TIE SKETCH Show at least four ties, also fence lines, roads, topo, size and type of witness trees' and if off road - best way to urive at corner. SEE CSM 4447 1'4" Pao 15.16' EAST CSM 3437 1'4" Paos © Row 66.86' wide	DATA SHOWN HERE ON CERTIFIED CORRECT: Registered Land Surveyor DATE:
TIE SKETCH Show at least four ties, also fence lines, roads, topo, size and type of witness trees' and if off road - best way to wrive at corner. SEE CSM 4447 1'4" Roo 15.16' EAST CSM 3437 1'4" Roos @ Row 66.86' wide	DATA SHOWN HERE ON CERTIFIED CORRECT: Ten Schuetto Registered Land Surveyor DATE: 3 Mach 198/
TIE SKETCH Show at least four ties, also fence lines, roads, topo, size and type of witness trees' and if off road - best way to wrive at corner. SEE CSM 4447 1'4"Pao 15.16' EHST CSM 3437 1'4"Poos @ Pow 66.86' wide PK Shace 11.43	DATA SHOWN HERE ON CERTIFIED CORRECT: Registered Land Surveyor DATE:
TIE SKETCH Show at least four ties, also fence lines, roads, topo, size and type of witness trees' and if off road - best way to rrive at corner. SEE CSM 4447 1'4"Pao 15.16' EAST CSM 3437 1'4"Poos @ Row 66.86' wide PK Shace 11.43	DATA SHOWN HERE ON CERTIFIED CORRECT: Ten Schuetto Registered Land Surveyor DATE: 3 Mach 198/
TIE SKETCH Show at least four ties, also fence lines, roads, topo, size and type of witness trees' and if off road - best way to rrive at corner. SEE CSM 4447 1/4"Roo 15.16' EAST CSM 3437 1"4"Roos @ Row 66.86' wide PK Shince 1.43 N 7"DA. BLACK OAK.	DATA SHOWN HERE ON CERTIFIED CORRECT: Registered Land Surveyor DATE: 3 Mach 198/ Cogging
roper location of Harrisin as reset. Now Constitution of Harrisin as reset.	DATA SHOWN HERE ON CERTIFIED CORRECT: Registered Land Surveyor DATE: 3 Mach 198/ Cogging
TIE SKETCH Show at least four ties, also fence lines, roads, topo, size and type of witness trees' and if off road - best way to rrive at corner. SEE CSM 4447 1/4"Roo 15.16' EMST CSM 3437 1/4"Roos @ Row 66.86' wide MAINTENANCE RECORD Date Init. Remarks	DATA SHOWN HERE ON CERTIFIED CORRECT: Ten Schuetto Registered Land Surveyor DATE: 3 Mach 198/
TIE SKETCH Show at least four ties, also fence lines, roads, topo, size and type of witness trees' and if off road - best way to prive at corner. SEE CSM 4447 1/4"Roo 15.16' EMST CSM 3437 1"4"Roos & Row 66.86' wide MAINTENANCE RECORD	DATA SHOWN HERE ON CERTIFIED CORRECT: Registered Land Surveyor DATE: 3 Mach 198/ Cogging

CORRECTION MAP CORNER NO. -17 ADAMS COUNTY RECID 4-27-81 SECTION Survey Monument Record TOWN TYPE OF MONUMENT: __30" HARRISON RANGE STATE PLANE COORDINATES: N_ ELEVATION - M.S.L. DATUM: _ THETA ANGLE: _ FIELD BOOK: _ _ PAGE _ BASIS FOR MONUMENT LOCATION (Use reverse side if necessary) Show info such as: History of corner, with reference to Vol. and pg, dates, surveyor; exact description of monument replaced; if location computed, by taped or EDM traverse; landowner SEAL: TRAVERSE SECTION BY EDM AND T-2. SET CORNER ON LINE AND PRORATED AS PER M.C. Smiths Notes. Found No Evidence of M.C. Smiths BEARING TREES AS PER HIS Survey 28 March 1918. OK 3-14-79 OK IMARCH 94 CR-JG 2-GONE 1-NEW 1-15-04 JG-JS Registered Land Surveyor TIE SKETCH (Show at least four ties) 10" SEE ESM MSA # 4447 774 1 AND 3437-ROW 66,86 8.39 PK/ShineR

REVISED 1974

REMNANTS