19 TOWN

ADAMS COUNTY COUNTY COUNTY CORNER NO: 28 ROMPORTOL ID: 41905030020


PUBLIC LAND SURVEY MONUMENT RECORD

HARRISON TYPE OF MONUMENT: ADAMS COUNTY COORDINATES, NAD 83 (1905) N. 282220.397 E. 512324.540 **ELEVATION-**DATUM_ 10/01/2019 FIELD WORK DATE:

BASIS FOR MONUMENT LOCATION

1980 - PLS 1478 SET MONUMENT EQUIDISTANT AND ON LINE BETWEEN ADJACENT SECTION CORNERS. NO EXCAVATION WAS MADE DUE TO CUT IN ROADWAY.

2019 - PLS 2675 FOUND HARRISON MONUMENT 8"± BELOW THE ROAD SURFACE AND DID NOT RECOVER ANY TIES OR WITNESSES. THE MONUMENT IS ONLINE AND EQUIDISTANT BETWEEN ADJACENT CORNERS. ACCEPTED THE HARRISON MONUMENT AS THE CORNER LOCATION AND ST 4 NEW TIES.

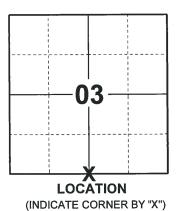

SEAL: The SURVEY OF THE PROPERTY OF


DATA SHOWN HERE ON THIS TIE SHEET IS CORRECT AND COMPLETE TO THE BEST OF MY KNOWLEDGE AND BELIEF.

PROFESSIONAL LAND SURVEYOR

-TIE SKETCH

NOTE: THE CORNER FALLS 1.4'± SOUTH OF BEAVER AVE. CENTERLINE.



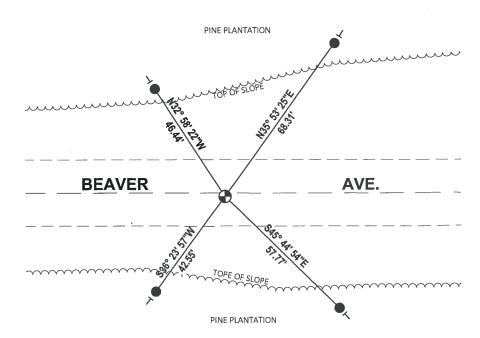

- SET 3/4" x 18" IRON REBAR, 1.50#/FT
 - FOUND HARRISON MONUMENT
- VINYL "T" POST

TYPE OF MONUMENT: Havvison Monument STATE PLANE COORDINATES: N	4 N
ELEVATION — M.S.L. DATUM: THETA ANGLE: FIELD BOOK: BASIS FOR MONUMENT LOCATION Show info such as: History of corner, with reference to Vok. and pg., dates, surveyor; exact description of monument replaced; if location computed, by taped or EDM traverse; landowner remarks, etc. (Use reverse side if necessary) ERAIL.	4 N
ELEVATION — M.S.L. DATUM: THETA ANGLE: FIELD BOOK: B3 PAGE 68 DRAWN BY: Greg Phinehart BASIS FOR MONUMENT LOCATION Show info such as: History of corner, with reference to Vol. and pg., dates, surveyor; exact description of monument replaced; if location computed, by taped or EDM traverse; landowner remarks, etc. (Use reverse side if necessary) SEAL.	4
THETA ANGLE: FIELD BOOK: BASIS FOR MONUMENT LOCATION Show info such as: History of corner, with reference to Vok. and pg., dates, surveyor; exact description of monument replaced; if location computed, by taped or EDM traverse; landowner remarks, etc. (Use reverse side if necessary) SEAL.	
BASIS FOR MONUMENT LOCATION Show info such as: History of corner, with reference to Vol. and pg., dates, surveyor; exact description of monument replaced; if location computed, by taped or EDM traverse; landowner remarks, etc. (Use reverse side if necessary) SEAL.	
Show info such as: History of corner, with reference to Vol. and pg., dates, surveyor; exact description of monument replaced; if location computed, by taped or EDM traverse; landowner remarks, etc. (Use reverse side if necessary) LOCATION (Indicated by 'X')	
Show info such as: History of corner, with reference to Vol. and pg., dates, surveyor; exact description of monument eplaced; if location computed, by taped or EDM traverse; andowner remarks, etc. (Use reverse side if necessary) LOCATION (Indicated by 'X')	
andowner remarks, etc. (Use reverse side if necessary) (Indicated by 'X')	
landowner remarks, etc. (Use reverse side if necessary) (Indicated by 'X')	
Set monument equidistant & on line between adjacent section corners. No excavation was made due to Cut in road way. OK - 7-17-84 MK-DK GREGORY P. RHINEHART S-1478 Wisconsin Rapids Wis.	
Set monument equidistant & on line between adjacent section corners. No excavation was made due to Cut in road way. OK -7-17-84 MK-DK GREGORY P. RHINEHART S-1478 Wisconsin Rapids Wis.	
between adjacent section corners. A GREGORY P. RHINEHART S-1478 Wisconsin Rapids Wisconsin	
No excavation was made due to Cut in road way. OK - 7-17-84 MK-DK GREGORY P. RHINEHART S-1478 Wisconsin Rapids Wis.	, N. 18669
No excavation was made due to Wisconsin Rapids Wisconsin	503
0K-7-17-84 MK-DK	<u></u>
OK-7-17-84 MK-DK	
OK - 7-17 -84 MK- DK	
· · · · · · · · · · · · · · · · · · ·	1
12.28-39 ··	
OK MARCH 94 C/Z-JG DATA SHOWN HERE ON CERTIFIED CORRECT:	
OK 2-8-99-JG-SS Tregony PR	Lembard
1-NEW 1-13-04 TC Registered Land Spanleyor	
OK 2-12-09 55 DATE: Z-70-8	<u>'0</u>
TIE SKETCH	
Show at least four ties, also fence lines, roads, topo, size and type of witness trees' and if off road - best way to	
arrive at corner.	
SONE	
4'4 Sack Pine 18T	
5 Horway (a)	
Pine BY SELLA OFF AREST	
NOTHING AUAILABLE)	
Eealer 72 Avenue	
3.05 1 FC 7 8" NIA WILL	AY BLAZE
6" Jack Pine 18T	17 DAMEE
Sit 6 Vack Fine 18T	
305	
5" Norway Pine /BT 10'±	
Pine/at W	

MAINTENANCE RECORD

DATE	BY WHOM	REMARKS
·		