05 RANGE ADAMS COUNTY COUNTY CORNER NO: 29 ROMPORTOL ID: 41905030000

PUBLIC LAND SURVEY MONUMENT RECORD

HARRISON (BROKEN-TOP) TYPE OF MONUMENT: ADAMS COUNTY COORDINATES, NAD 83 (1905)

N. 282210.733

E. 514975.808


DATUM ELEVATION-

10/01/2019 FIELD WORK DATE:_

BASIS FOR MONUMENT LOCATION

1979 - PLS 878 EXCAVATED WITH BACKHOE, FOUND DEFINITE REMAINS OF BURNED POST, REPLACED SAME WITH HARRISON AND VERIFIED LOCATION WITH EDM TRAVERSE. POST SET PER VOLUME 3 OF OLD FIELD NOTES, PAGE 37.

2019 - PLS 2675 FOUND HARRISON (BROKEN-TOP) MONUMENT 8"± BELOW THE ROAD SURFACE AND 3 WITNESSES. THE MONUMENT AGREES WITH ALL 3 WITNESSES. ACCEPTED THE HARRISON (BROKEN-TOP) AS THE CORNER LOCATION. SET 4 NEW TIES AND MEASURED TO THE EXISTING WITNESSES.

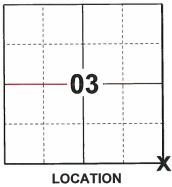

(INDICATE CORNER BY "X")



DATA SHOWN HERE ON THIS TIE SHEET IS CORRECT AND COMPLETE TO THE BEST OF MY KNOWLEDGE AND BELIEF.


PROFESSIONAL LAND SURVEYOR

DATE

-TIE SKETCH

NOTE: THE CORNER FALLS ON THE CENTERLINE OF BEAVER AVE. AND 3.6'± WEST OF 16TH AVE. CENTERLINE.



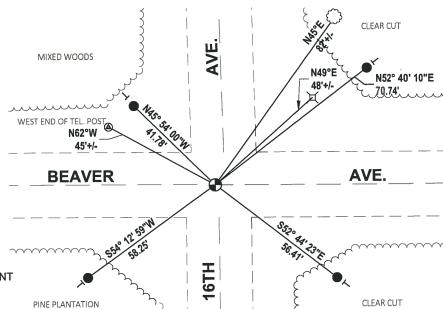

- SET 3/4" x 18" IRON REBAR, 1.50#/FT
- FOUND HARRISON (BROKEN-TOP) MONUMENT
- VINYL "T" POST
- WITNESS TREE

Government Land Corner Certificate	
Adams County	corner no. <u>29</u>
TYPE OF MONUMENT: Harrisan	SECTION //
STATE PLANE COORDINATES: N	TOWN
E	RANGE 5
ELEVATION — M.S.L. DATUM:	*
THETA ANGLE: 74 (102) PAGE //2 (53)	
DRAWN BY: N. J	
	$=$ \vdash \uparrow \uparrow \uparrow \uparrow \uparrow \uparrow
BASIS FOR MONUMENT LOCATION	***
Show info such as: History of corner, with reference to Vol.	
and pg., dates, surveyor; exact description of monument replaced; if location computed, by taped or EDM traverse:	LOCATION
landowner remarks, etc. (Use reverse side if necessary)	(Indicated by 'X') SEAL:
Excavated with backhoe, found definite	4 A B S R B B B B
remains of burned post. Replaced same with	BRITINISCONO IN
Harrison and verified location with EDM traverse. Post set per Vol 3 of old field notes,	ANTHONY B.
page 37.	KIEDROWSKI S-878
•	Wisconsin Rapids,
k 4-12-84 SS-DK - / _{さら} ぴ-ぷら おり	ANTHONY B. KIEDROWSKI S-878 Wisconsin Rapids, Wis.
> 13-33-34 CR-34	AND THE STATE OF T
	NAME OF PERSONS
2-GONE, 2-NEW, TO P BROKEN OFF, 2-12-98-JG DK 12-31-02-JG 2 NEW TIES 2-12-09 SS	
2 NEW TIES 2-12-09 55	DATA SHOWN HERE ON CERTIFIED CORRECT:
	And koung Koolen El' Registered Land Surveyor
	DATE: 10/25/79
TIE SKETCH	
Show at least four ties, also fence lines, roads, topo, size and type of witness trees' and if off road - best way to	
arrive at corner.	
My GONE (M 12" BIK
JACK THOSE	O) OAK/BT
NEW SIGN	, jo
GROPSIAN 300 8	11 Tale
WEST FLANGE USL 1111	pedestal
G BEAVER TELE CABLE 44.50'	AVE.
John Marie M	> > 7
MEX SON	TS60° E PINE B
Emily H	FINE O
5 JACK TOE/	BI BIK OAK
PINE 69	***

MAINTENANCE RECORD

BY WHOM	REMARKS
	·