ADAMS COUNTY COU

PUBLIC LAND SURVEY MONUMENT RECORD


HARRISON TYPE OF MONUMENT: ADAMS COUNTY COORDINATES, NAD 83 (1905) N. 279594.883 F 499028.939 DATUM **ELEVATION-**10/15/2019 FIELD WORK DATE:_

BASIS FOR MONUMENT LOCATION

1974 - PLS 1103 FOUND A NAIL SET BY MIDSTATES AND ASSOCIATES AN D ACCEPTED THE LOCATION BECAUSE IT FIT THE OTHER SECTION DATA. SET A HARRISON MONUMENT IN ITS PLACE:

2010 - PLS 1473 THE HARRISON MONUMENT WAS FOUND 1.0' UNDER THE ROAD SURFACE, SO I SET A 5" GALVANIZED LANDSCAPE SPIKE OVER THE TOP OF THE MONUMENT.

2019 - PLS 2675 FOUND SPIKE IN THE ROAD SURFACE, REMOVED, AND FOUND HARRISON MONUMENT 12"± BELOW THE ROAD SURFACE AND 3 TIES. THE MONUMENT AGREES WITH ALL 3 TIES. ACCEPTED THE HARRISON MONUMENT AS THE CORNER LOCATION, SET 2 NEW TIES AND MEASURED TO THE EXISTING TIES.

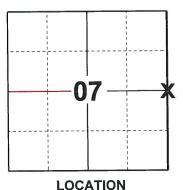

(INDICATE CORNER BY "X")



DATA SHOWN HERE ON THIS TIE SHEET IS CORRECT AND COMPLETE TO THE BEST OF MY KNOWLEDGE AND BELIEF.


PROFESSIONAL LAND SURVEYOR

-TIE SKETCH

NOTE: THE MONUMENT FALLS 3'± EAST OF CTH 'Z' CENTERLINE.



- SET 3/4" x 18" IRON REBAR, 1.50#/FT
- FOUND 3/4" IRON ROD FOUND 1-1/4" O.D. IRON ROD
- FOUND 2-3/8" O.D. IRON PIPE
- FOUND HARRISON MONUMENT
- VINYL "T" POST

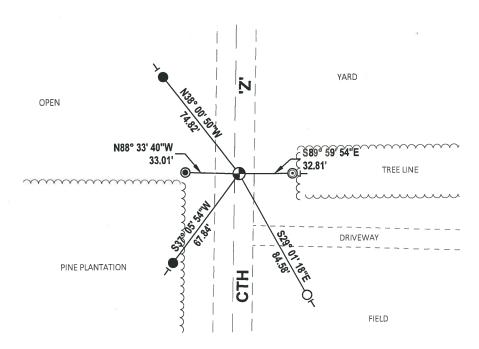

U.S PUBLIC LAND SURVEY MONUMENT RECORD ADAMS COUNTY, WISCONSIN

CORNER NO. 635 SECTION 8 TOWN 19 N RANGE 5 E

TYPE OF MONUMENT: 5" GALVANIZED LANDSCAPING SPIKE OVER HARRISON MON. ADAMS COUNTY COORDINATES:


NORTH: 279594.91' EAST: 499028.92'

ELEVATION _ MSL DATUM: NOT APPLICABLE

THETA ANGLE: NOT APPLICABLE

FIELD BOOK:

DRAWN BY: DANIEL MARKS

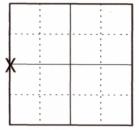

LOCATION

BASIS FOR MONUMENT LOCATION

On December 24, 1974 Dale C. Hagen found a nail set by Midstates and Associates and accepted the location because it fit the other section data. Hagen set a Harrison monument in its place. The Harrison monument was set 1.0' under the surface so I set a 5" galvanized landscape spike over the top of the monument.





DATA SHOWN HEREON CERTIFIED CORRECT:

Smh (Man L

REGISTERED LAND SURVEYOR

DATE: 7-28-2010

