

## PUBLIC LAND SURVEY MONUMENT RECORD

TYPE OF MONUMENT: HARRISON (BROKEN-TOP)  
ADAMS COUNTY COORDINATES, NAD 83 (1905)

N. 279594.016

E. 520247.103


ELEVATION- - - - - DATUM - - - - -

FIELD WORK DATE: 10/08/2019

### BASIS FOR MONUMENT LOCATION

1980 - PLS 1478 SET EQUIDISTANT AND ON LINE BETWEEN ADJACENT SECTION CORNERS. NO EVIDENCE OF ANY PREVIOUS MONUMENTATION WAS FOUND. NO RECORD OF ANY SURVEY SUBSEQUENT TO THE ORIGINAL WAS FOUND.

2019 - PLS 2675 FOUND HARRISON (BROKEN-TOP) 8"± BELOW THE GROUND AND 1 WITNESS. THE MONUMENT AGREES WITH THE WITNESS. ACCEPTED THE HARRISON (BROKEN-TOP) MONUMENT AS THE CORNER LOCATION. SET 4 NEW TIES AND MEASURED TO THE EXISTING WITNESS.

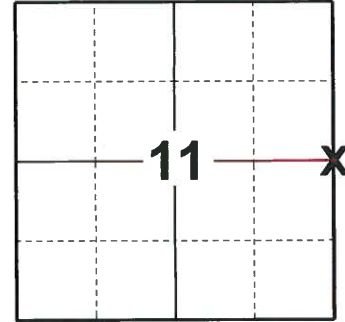

### LOCATION

(INDICATE CORNER BY "X")

SEAL:




DATA SHOWN HERE ON THIS TIE SHEET IS CORRECT AND COMPLETE TO THE BEST OF MY KNOWLEDGE AND BELIEF.

PROFESSIONAL LAND SURVEYOR

DATE 11/25/19

### TIE SKETCH

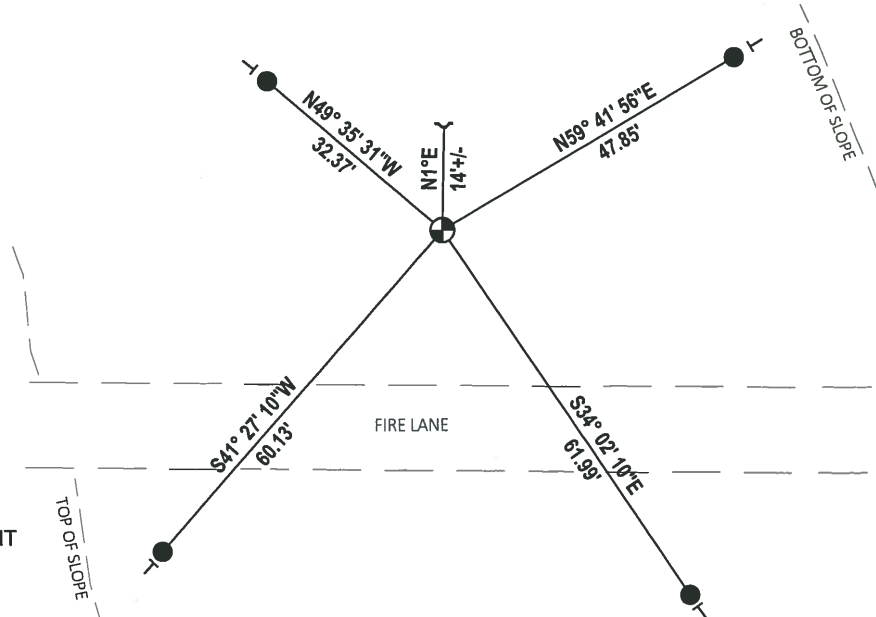


- SET 3/4" x 18" IRON REBAR, 1.50#/FT
- ⊕ FOUND HARRISON (BROKEN-TOP) MONUMENT
- ┌ STEEL FENCE POST
- └ VINYL "T" POST

# Government Land Corner Certificate

ADAMS County  
 TYPE OF MONUMENT: HARRISON STANDARD *Present 1" IP to be replaced*  
 STATE PLANE COORDINATES: N \_\_\_\_\_ E \_\_\_\_\_  
 ELEVATION — M.S.L. DATUM: \_\_\_\_\_  
 THETA ANGLE: \_\_\_\_\_ *SET HAR. 4/22/80 RH-SS*  
 FIELD BOOK: 83 PAGE 41  
 DRAWN BY: R. NUBER

CORNER NO. 39  
 SECTION 11  
 TOWN 19  
 RANGE 5

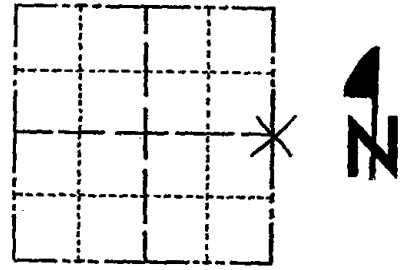

LOCATION  
(Indicated by 'X')

## BASIS FOR MONUMENT LOCATION

Show info such as: History of corner, with reference to Vol. and pg., dates, surveyor; exact description of monument replaced; if location computed, by taped or EDM traverse; landowner remarks, etc. (Use reverse side if necessary)

SEAL:

Set equidistant and on line between adjacent section corners. No evidence of any previous monumentation was found. No record of any survey subsequent to the original was found.

All ties were destroyed prior to this check. For new sketch of the location of the monument see back of this sheet.



DATA SHOWN HERE ON  
CERTIFIED CORRECT

*Gregory P. Rhinehart*  
Registered Land Surveyor

DATE: 1 / 8 / 1980

## TIE SKETCH

Show at least four ties, also fence lines, roads, topo, size and type of witness trees and if off road - best way to arrive at corner.

