# O5 RANGE ADAMS COUNTY CORNER NO: 47 ROMPORTOL ID: 41905090000

# PUBLIC LAND SURVEY MONUMENT RECORD


**HARRISON** TYPE OF MONUMENT: ADAMS COUNTY COORDINATES, NAD 83 (1905) N. 276930.552 E. 509585.574 DATUM **ELEVATION-**

10/09/2019 FIELD WORK DATE:\_\_


#### BASIS FOR MONUMENT LOCATION

1973 - PLS 878 LOCATION OF THIS CORNER WAS DETERMINED BY TRAVERSING. INTERSECTION WAS EXCAVATED WITH A BACKHOE. NOTHING WAS FOUND. ROADS ARE DIRT.

2019 - PLS 2675 FOUND HARRISON MONUMENT 8"± BELOW THE ROAD SURFACE AND 2 WITNESSES. TIE ORIGIN UNKNOWN. THE MONUMENT AGREES WITH BOTH WITNESSES. ACCEPTED THE HARRISON MONUMENT AS THE CORNER LOCATION. SET 2 NEW TIES AND MEASURED TO THE TIES AND EXISTING WITNESSES.

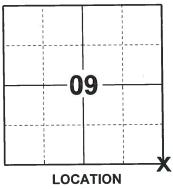

(INDICATE CORNER BY "X")

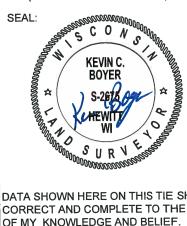


DATA SHOWN HERE ON THIS TIE SHEET IS CORRECT AND COMPLETE TO THE BEST OF MY KNOWLEDGE AND BELIEF.

PROFESSIONAL JAND SURVEYOR

#### -TIE SKETCH

NOTE: THE CORNER FALLS 16'± EAST OF 17TH AVE. CENTERLINE AND 12'± SOUTH OF BIGHORN AVE. CENTERLINE.



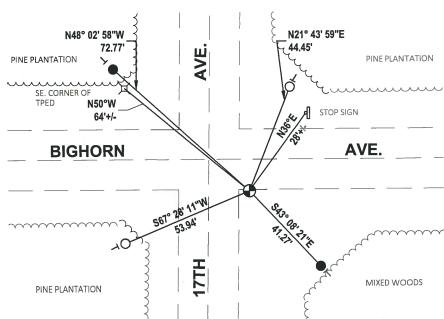

- SET 3/4" x 18" IRON REBAR, 1.50#/FT
- FOUND 3/4" IRON ROD
- FOUND HARRISON MONUMENT
- VINYL "T" POST

## ADAMS COUNTY

# Survey Monument Record


TYPE OF MONUMENT: HARRISON MONUMENT

STATE PLANE COORDINATES: N\_\_\_\_

ELEVATION — M.S.L. DATUM: \_

THETA ANGLE: \_\_\_\_

FIELD BOOK: 105 PAGE 74

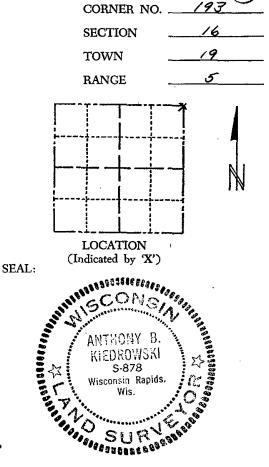

### BASIS FOR MONUMENT LOCATION

(Use reverse side if necessary)

Show info such as: History of corner, with reference to Vol. and pg, dates, surveyor; exact description of monument replaced; if location computed, by taped or EDM traverse; landowner remarks, etc.

Location of this corner was determined by traverseing.

September 8, 1972

Anthony B. Kiedrowski R.L.S. 878

Entires intersection was excavated with a backhoe. Nothing was found. Roads are dirt.

Ok 3-21-84 SS - 2 New 7-17-84

OK 3-20-79 RN-SS OK 2-25-94 CJ-34 OK 1-25-99-JG 3-NEW, 1-GONE, 1-6-04-JG OK 1-14-09 SS

CERTIFIED CORRECT:

And Surveyor

DATE: 1-30-73

#### TIE SKETCH

