

PUBLIC LAND SURVEY MONUMENT RECORD

TYPE OF MONUMENT: HARRISON
 ADAMS COUNTY COORDINATES, NAD 83 (1905)

N. 276925.314

E. 512253.566


ELEVATION- _____ DATUM _____

FIELD WORK DATE: 10/09/2019

BASIS FOR MONUMENT LOCATION

1980 - PLS 1478 SET MONUMENT EQUIDISTANT AND ON LINE BETWEEN ADJACENT SECTION CORNERS. NO EVIDENCE OF ANY PREVIOUS MONUMENTATION WAS FOUND. NO RECORD OF ANY MONUMENTATION SUBSEQUENT TO THE ORIGINAL WAS FOUND.

2019 - PLS 2675 FOUND HARRISON MONUMENT 18"± BELOW THE GROUND, 1 TIE AND 1 WITNESS. THE MONUMENT AGREES WITH THE EXISTING TIE AND WITNESS. ACCEPTED THE HARRISON MONUMENT AS THE CORNER LOCATION. SET 4 NEW TIES AND MEASURED TO THE EXISTING TIE AND WITNESS.

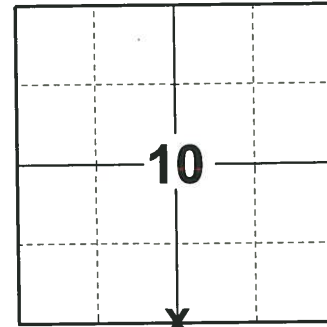

LOCATION

(INDICATE CORNER BY "X")

SEAL:





DATA SHOWN HERE ON THIS TIE SHEET IS CORRECT AND COMPLETE TO THE BEST OF MY KNOWLEDGE AND BELIEF.

PROFESSIONAL LAND SURVEYOR

DATE 11/25/19

TIE SKETCH

NOTE: THE CORNER FALLS 16'± BIGHORN AVE. CENTERLINE.

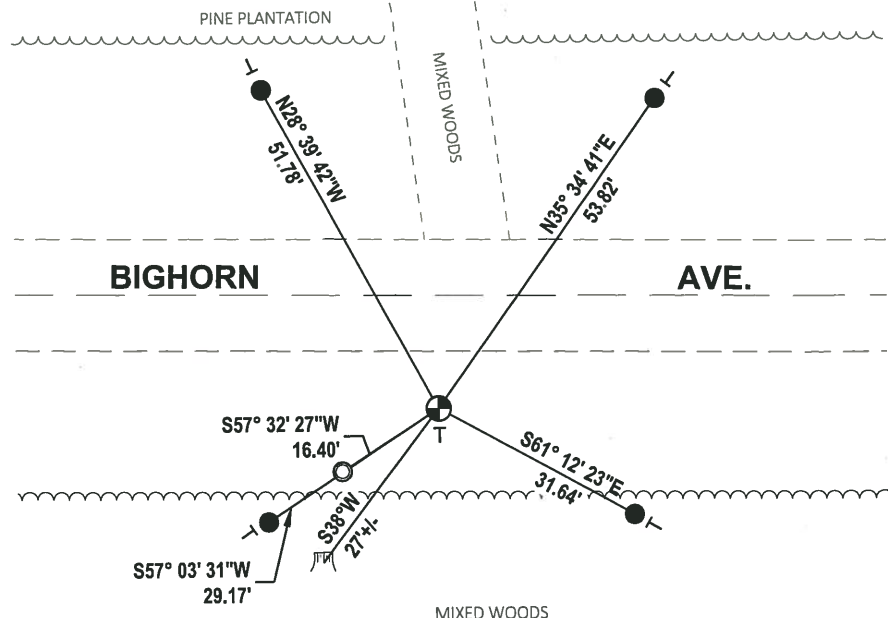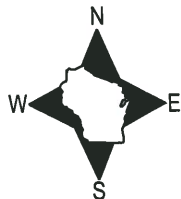


- SET 3/4" x 18" IRON REBAR, 1.50#/FT
- FOUND 1-1/4" O.D. IRON PIPE
- ⊙ FOUND HARRISON MONUMENT
- ┌ VINYL "T" POST
- ▣ WITNESS STUMP

Government Land Corner Certificate

SET MARK
4/21/80
RN-SS

CORNER NO. 48
SECTION 10
TOWN 19
RANGE 5

ADAMS County
TYPE OF MONUMENT: HARRISON STANDARD 1-24-27 to be
STATE PLANE COORDINATES: N _____ revised
E _____ Spring 77
ELEVATION — M.S.L. DATUM: _____
THETA ANGLE: _____
FIELD BOOK: B3 PAGE 57
DRAWN BY: G. RHINEHART

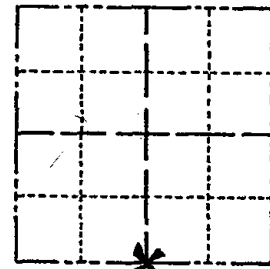

LOCATION
(Indicated by 'X')

BASIS FOR MONUMENT LOCATION

Show info such as: History of corner, with reference to Vol. and pg., dates, surveyor; exact description of monument replaced; if location computed, by taped or EDM traverse; landowner remarks, etc. (Use reverse side if necessary)

Set monument equidistant and on line between adjacent section corners. No evidence of any previous monumentation was found. No record of any monumentation subsequent to the original was found.

SEAL:



DATA SHOWN HERE ON
CERTIFIED CORRECT:

Gregory P. Rhinehart
Registered Land Surveyor

DATE: _____

OK-7-17-84 DK-SS
47125 HAYKING 1-27-83
OK-2-25-9A CR-24
3-GONE, 3-NEW, 1-6-04-JG
1-14-09 SS

TIE SKETCH

Show at least four ties, also fence lines, roads, topo, size and type of witness trees and if off road - best way to arrive at corner.

