# ADAMS COUNTY COUNTY COUNTY CORNER NO: 49 ROMPORTOL ID: 41905100000

## PUBLIC LAND SURVEY MONUMENT RECORD

HARRISON (BROKEN-TOP) TYPE OF MONUMENT: ADAMS COUNTY COORDINATES, NAD 83 (1905)

N. 276920.095

E. 514920.923


DATUM\_ ELEVATION-

10/09/2019 FIELD WORK DATE:


#### BASIS FOR MONUMENT LOCATION

1980 - PLS 1478 INTERSECTION DISTANCE FROM THE NORTH HALF OF THE WEST LINE OF SECTION 10 AND THE DISTANCE OF THE EAST HALF OF THE SOUTH LINE OF SECTION 10 TO DETERMINE THE LOCATION OF THIS CORNER. DISTANCES TO ADJACENT SECTION CORNERS TO THE WEST AND SOUTH "FIT" QUITE WELL. EXCAVATION WITH BACKHOE YIELDED NO EVIDENCE OF PREVIOUS MONUMENTATION.

2019 - PLS 2675 FOUND HARRISON (BROKEN-TOP) MONUMENT 8"± BELOW THE ROAD SURFACE AND 2 WITNESS TREES, THE 2 FOUND WITNESS TREES ARE NOT SHOWN ON THE CURRENT TIE SHEET (UPDATED 1-14-09). ACCEPTED THE HARRISON (BROKEN-TOP) MONUMENT AS THE CORNER LOCATION. SET 4 NEW TIES AND MEASURED TO THE WITNESS TREES.

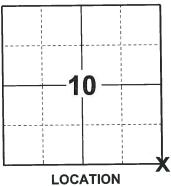

(INDICATE CORNER BY "X")

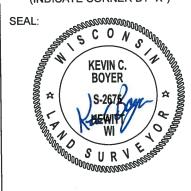


DATA SHOWN HERE ON THIS TIE SHEET IS CORRECT AND COMPLETE TO THE BEST OF MY KNOWLEDGE AND BELIEF.

PROFESSIONAL LAND SURVEYOR

#### -TIE SKETCH

NOTE: THE CORNER FALLS 12.1'± EAST OF 16TH AVE. CENTERLINE AND 16.5'± SOUTH OF BIGHORN AVE. CENTERLINE.



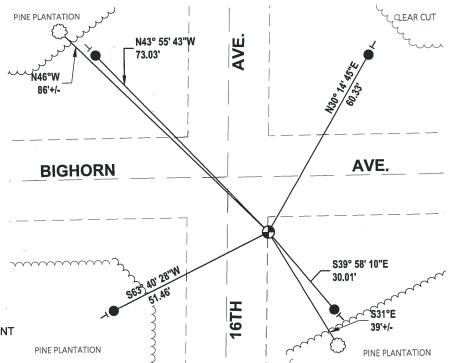

- SET 3/4" x 18" IRON REBAR, 1.50#/FT
- FOUND HARRISON (BROKEN-TOP) MONUMENT
- VINYL "T" POST
- WITNESS TREE

	MAR.	SZT		
Government Land Corner Certificate	4/21/8 RM-55	0		49
ADAMS County			CORNER NO.	
Type of Monument Temporay 1"X24" Iron Pip	e to be	4000	SECTION	
STATE PLANE COORDINATES: N	Spring	1980	TOWN	
<u> </u>			RANGE	
ELEVATION M.S.L. DATUM:	•			<b>7</b>
THETA ANGLE: PAGE 39			<u> </u>	
DRAWN BY: R. NUBER	,			i 5.
		=		
BASIS FOR MONUMENT LOCATION				
Show info such as: History of corner, with reference to Vol.				
and pg., dates, surveyor; exact description of monument replaced; if location computed, by taped or EDM traverse; landowner remarks, etc. (Use reverse side if necessary)		-	LOCATION	
Intersected distance from the north half of	• #h- ·/	SEAL:	(Indicated by 'X')	
west line of Section 10 and the distance of	and the second second	j	ANTHING CO	NS
east half of the south line of SEction 10 t	o determ	ine the	ARINA LE	- 1 18 M
location of this corner. Distances to adja sextion corners to the west and south "fi			GREGO	DRY P.
quite well.	.u~	` <b>i</b>	RHINE S-1	HART 478
•	,_		Wiscons	in Rapids
Excavation with backhoe yielded no evidenc previous monumentation.	e of		E.	A LEAD OF BEEN
OK 4-17-84 SS-DK			GREGORHINE S-1 Wiscons	ORY P. CHART 478 in Rapids lis.
OK, 2-12-98-JG		DATA	SHOWN HERE ON	
3-NEW, TOP BROKEN OFF MON., 1-02-03-JG 3 REMAIN 1-14-09 SS			IED CORRECT:	~
3 (camisms )-14-09 33		لار	ugon PR	himlas
		Registere	d Lland Surveyor 1116/80	
	·—-	DATE:		
TIE SKETCH			· · · · · · · · · · · · · · · · · · ·	
Show at least four ties, also fence lines, roads, topo, size		_		
and type of witness trees' and if off road - best way to arrive at corner.		Pur	OED OL NORWAY/BT	)T
(DEST)	1	1021	NORWAY/BT	
NOR 34 NOR	WAY/BT ;	<b>₹</b> 3	AREA	
1	6		7,,,,,,	
& BIGHORN	an'		AVE	
	è	-		<del>-</del>
	عفد ا			
	<b>*</b>	31 KEZ 38.151	<u>/_ 3/6//</u>	
7 JACK PINE/BT 74.87				
7" JACK PINE/BT 14,87'	24,	66-	3176"NORU	IAY /BT
17,81	24.	66-	~ -	PAY/BT
in l	24.	66-+	STEEL POST	
17. BY	74.	66-	~ -	
(DEAD)	24.	66-	~ -	
(DEAD)	24.	66-	~ -	
(DEAD)	24,	66-	~ -	

### MAINTENANCE RECORD

DATE	BY WHOM	REMARKS
7-7-89	MK-55	/ NEW 7/E
		·
		·