TOWN

# ADAMS COUNTY COUNTY COUNTY CORNER NO: 56 ROMPORTOL ID: 41905172000

## PUBLIC LAND SURVEY MONUMENT RECORD

**HARRISON (BROKEN-TOP)** TYPE OF MONUMENT: ADAMS COUNTY COORDINATES, NAD 83 (2005) N.\_274299.808


E. 504257.398 \_\_ DATUM\_ **ELEVATION-**

FIELD WORK DATE: 10/17/2019


#### BASIS FOR MONUMENT LOCATION

1972 - PLS 878 DETERMINED BY TRAVERSING, SET BY RETRACEMENT OF A SAM MULLEN SURVEY AND A TRAVERSE AROUND THE ENTIRE SECTION.

2019 - PLS 2675 FOUND HARRISON BROKEN-TOP 12" BELOW THE ROAD SURFACE, 1 TIE, AND 2 WITNESSES. ACCEPTED THE HARRISON BROKEN-TOP AS THE CORNER LOCATION. SET 1 NEW TIE, MEASURED TO 2 FOUND PROPERTY IRONS, AND THE EXISTING TIE AND WITNESSES.

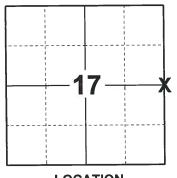

**LOCATION** (INDICATE CORNER BY "X")

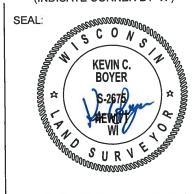


DATA SHOWN HERE ON THIS TIE SHEET IS CORRECT AND COMPLETE TO THE BEST OF MY KNOWLEDGE AND BELIEF.

PROFESSIONAL LAND SURVEYOR DATE \_11/25

#### -TIE SKETCH



- SET 3/4" x 18" IRON REBAR, 1.50#/FT
- FOUND 3/4" IRON ROD
- FOUND HARRISON MONUMENT (BROKEN-TOP)
- STEEL FENCE POST
- VINYL "T" POST
- WITNESS TREE

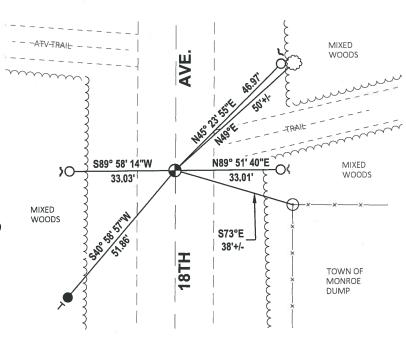

### ADAMS COUNTY CORNER NO. \_ **SECTION** Survey Monument Record **TOWN** TYPE OF MONUMENT: HARRISON MONUMENT RANGE STATE PLANE COORDINATES: N\_ F. ELEVATION - M.S.L. DATUM: \_ THETA ANGLE: PAGE \_53 FIELD BOOK: 105 BASIS FOR MONUMENT LOCATION (Use reverse side if necessary) LOCATION Show info such as: History of corner, with reference to Vol. and pg, dates, surveyor; exact description of monument replaced; if location computed, by taped or EDM traverse; landowner (Indicated by 'X') SEAL: ANTHONY B. KIEDROWSKI S-878 Wisconsin Rapids. Wis. remarks, etc. determined by traverseing August 9, 1972 Anthony B. Kiedrowski R.L.S. 878 Set by retracement of a Sam Mullen survey and a traverse around the entire section. 0k 4-21-84 DK-SS 2-25-94 CR-JG CERTIFIED CORRECT: ZNEW TIES 3-20-79 411.55 00 7-25-94 MC OK DATE: OK 1-25-99- JG 1-GONE, Z-NEW, 1-5-04-JG (Show at least four ties) 1-26-09 55-M5" STUMP" JACK PINE NAILFWASHER 3/4 ROD 33.00' 33.00 PK NAIL IN 4" TREATED FENCE POST DRIVEWAY TO TOWN COMP E