TYPE OF MONUMENT:

O4 ADAMS COUNTY

COUNTY CORNER NO: 73

ROMPORTOL ID: 41904130000

PUBLIC LAND SURVEY MONUMENT RECORD


ADAMS COUNTY COORDINATES, NAD 83 (2007) N. **271661.720** E. 494677.090 **ELEVATION-**DATUM — — — FIELD WORK DATE: 1/18/2018

HARRISON (BROKEN-TOP)


BASIS FOR MONUMENT LOCATION

1977 - PLS 878 EXCAVATED WITH A BACKHOE AND FOUND NOTHING. CORNER WAS CALCULATED FROM 2" CAPPED WITNESS MONUMENTS OF UNKNOWN ORIGIN. LOCATION VERIFIED BY EDM TRAVERSE. TIED OUT CORNER.

2018 - PLS 2994 FOUND HARRISON MONUMENT WITH A BROKEN-TOP 24" BELOW THE ROAD SURFACE AND 2 TIES. THE MONUMENT AGREES WITH THE EXISTING TIES. ACCEPTED THE HARRISON MONUMENT WITH A BROKEN-TOP AS THE CORNER LOCATION. SET 2 NEW TIES AND MEASURED TO THE TIES.

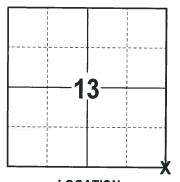

LOCATION (INDICATE CORNER BY "X")

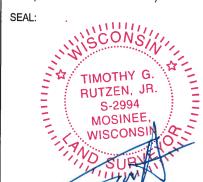

DATA SHOWN HERE ON THIS TIE SHEET IS CORRECT AND COMPLETE TO THE BEST OF MY KNOWLEDGE AND BELIEF.


PROFESSIONAL LAND SURVEYOR

3-1-18 DATE

- TIE SKETCH

NOTE: THE CORNER FALLS 3'± NORTH OF THE CENTERLINE OF BLACKHAWK AVE.



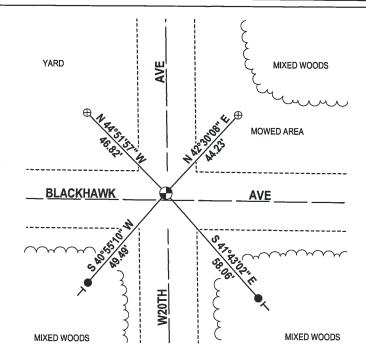

3/4" x 18" IRON REBAR SET, 1.50#/FT

⊕ 2-3/8" O.D. IRON PIPE FOUND HARRISON (BROKEN-TOP) FOUND

→ VINYL "T" POST

CORNER NO. _ ADAMS COUNTY SECTION Survey Monument Record TOWN Harrison TYPE OF MONUMENT: _ RANGE STATE PLANE COORDINATES: N ELEVATION — M.S.L. DATUM: THETA ANGLE: 38 FIELD BOOK: . **PAGE** BASIS FOR MONUMENT LOCATION (Use reverse side if necessary) **LOCATION** Show info such as: History of corner, with reference to Vol. and pg, dates, surveyor; exact description of monument replaced; if location computed, by taped or EDM traverse; landowner (Indicated by 'X') SEAL: Excavated with backhoe. Found Nothing. Corner set from 2" capped witness monuments of unknown origen. Location verified by EDM traverse. 0k 4-2-84 SS-DK S-878 11 11-29-88 55 Wisconsin Rapids, Wis. OK 3-14-79 RN-55 CERTIFIED CORRECT: 2-11-94-62-36 OK Registered Land Surveyor DATE: 5/4/77 OK 1-26-99-TG DATE: 2-GONE, 2-NEW, TOP BROKEN OFF, 1-5-04-JG TIE SKETCH 2" Capped Witness (Show at least four ties) Pipe-stamped 1-26-09 55-M5 2" Capped Witness Pipe - stamped 0 42.2' 'n & BLACKHAWA 4vE

5,85.65.95.

NW COR

TELE PED AT GROUND

DEAD, NAIL STILL GOOD