05 ADAMS COUNTY COUNTY CORNER NO: 63 ROMPORTOL ID: 41905180000

PUBLIC LAND SURVEY MONUMENT RECORD

TYPE OF MONUMENT: HA	ARRISON
ADAMS COUNTY COORDINATES, NAD 83 (2005)	
N. 271657.446	
E. 498915.611	
ELEVATION DATUM	
FIELD WORK DATE: 10/21/2019	

BASIS FOR MONUMENT LOCATION


1977 - PLS 878 EXCAVATED WITH A BACKHOE AND FOUND A 12'X12"X12" SOFT SANDSTONE WITH A 3" IRON PIPE DRIVEN INTO IT. HE LOWERED THE STONE AND SET A HARRISON MONUMENT ON TOP OF IT.

2010 - PLS 1473 FOUND A HARRISON MONUMENT BURIED 1.4' UNDER THE SURFACE AND SET A 5" GALVANIZED LANDSCAPING SPIKE OVER THE TOP OF IT.

2019 - PLS 2675 FOUND A SPIKE IN THE ROAD SURFACE, 3 TIES, 3 PROPERTY IRONS AND 1 WITNESS, REMOVED THE SPIKE AND FOUND A HARRISON MONUMENT 13" BELOW THE ROAD SURFACE. THE MONUMENT AGREES WITH THE EXISTING TIES AND WITNESS. ACCEPTED THE HARRISON MONUMENT AS THE CORNER LOCATION. RE-MEASURED TO THE EXISTING TIES, PROPERTY IRONS AND WITNESS.




(INDICATE CORNER BY "X")

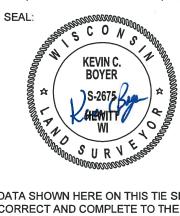

DATA SHOWN HERE ON THIS TIE SHEET IS CORRECT AND COMPLETE TO THE BEST OF MY KNOWLEDGE AND BELIEF.

PROFESSIONAL LAND SURVEYOR DATE_

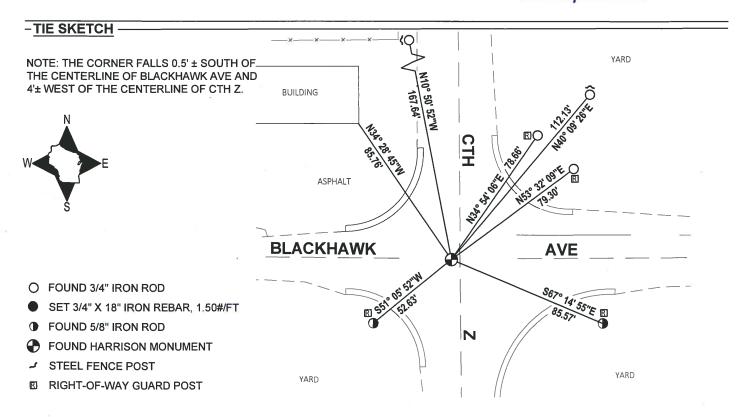

U.S PUBLIC LAND SURVEY MONUMENT RECORD ADAMS COUNTY, WISCONSIN

TYPE OF MONUMENT: 5" GALVANIZED LANDSCAPING SPIKE OVER HARRISON MON. ADAMS COUNTY COORDINATES:

NORTH: 271657.46' EAST: 498915.58'

ELEVATION MSL DATUM: NOT APPLICABLE

THETA ANGLE: NOT APPLICABLE

FIELD BOOK:

DRAWN BY: DANIEL MARKS



CORNER NO. SECTION 19

TOWN 19 N

LOCATION

BASIS FOR MONUMENT LOCATION

On May 3, 1977 Anthony B. Kiedrowski excavated with a backhoe and found a 12" x 12" x 12" soft sandstone with a 3/4" iron pipe driven into it. He lowered the stone and set a Harrison monument on top of it. The monument was buried 1.4' under the surface so I set a 5" galvanized landscaping spike over the top of it.





DATA SHOWN HEREON CERTIFIED CORRECT:

Jun L (Man L

REGISTERED LAND SURVEYOR DATE: August 1, 2010

