

24 SECTION 19 TOWN 05 RANGE

ADAMS COUNTY

COUNTY CORNER NO: 80

ROMPORTOL ID: 41905242000

PUBLIC LAND SURVEY MONUMENT RECORD

TYPE OF MONUMENT: HARRISON (BROKEN-TOP)
 ADAMS COUNTY COORDINATES, NAD 83 (2007)

N. 269024.903

E. 525444.907


ELEVATION- DATUM

FIELD WORK DATE: 01/16/2018

BASIS FOR MONUMENT LOCATION

1973 - PLS 878 EXCAVATED AREA WITH A BACKHOE AND FOUND A POINT OF AN OLD WOOD POST. THIS POINT WAS MONUMENTED AND USED TO ESTABLISH THE SOUTH EAST CORNER OF THE SECTION. THIS POINT IS ON A STRAIGHT LINE EQUIDISTANT BETWEEN SECTION CORNERS. SET A HARRISON MONUMENT AT THE CORNER LOCATION AND TIED OUT.


2018 - PLS 2994 FOUND A HARRISON MONUMENT WITH A BROKEN-TOP 12" BELOW THE GROUND SURFACE. FOUND NO EVIDENCE OF THE WITNESSES. ACCEPTED THE HARRISON MONUMENT WITH A BROKEN-TOP AS THE BEST EVIDENCE OF THE CORNER LOCATION. SET 4 NEW TIES AND MEASURED TO THE TIES.

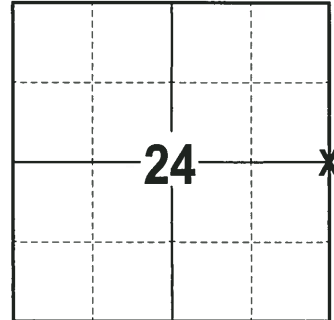

LOCATION

(INDICATE CORNER BY "X")

SEAL:

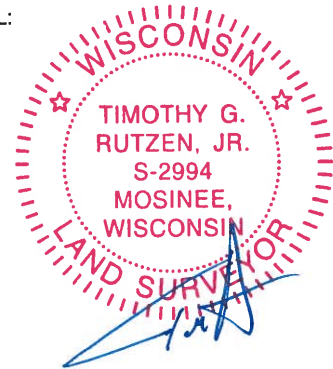



DATA SHOWN HERE ON THIS TIE SHEET IS CORRECT AND COMPLETE TO THE BEST OF MY KNOWLEDGE AND BELIEF.

PROFESSIONAL LAND SURVEYOR

DATE 3-1-18

- TIE SKETCH

NOTE: THE CORNER FALLS 19± EAST OF THE CENTERLINE OF 14TH AVE

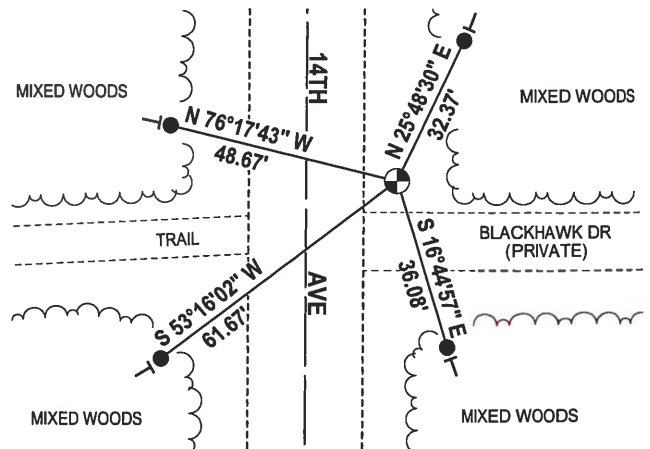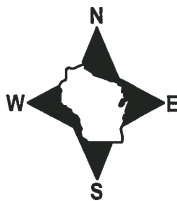

- 3/4" x 18" IRON REBAR SET, 1.50#/FT
- ⊕ HARRISON (BROKEN-TOP) FOUND
- VINYL "T" POST

ADAMS COUNTY

CORNER NO. 316
 SECTION 24
 TOWN 19
 RANGE 5

Survey Monument Record


TYPE OF MONUMENT: 30" HARRISON

STATE PLANE COORDINATES: N _____
E _____

ELEVATION — M.S.L. DATUM: _____

THETA ANGLE: _____

FIELD BOOK: 108 PAGE 102

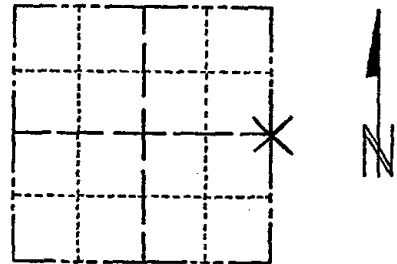

LOCATION
(Indicated by 'X')

SEAL:



BASIS FOR MONUMENT LOCATION

(Use reverse side if necessary)

Show info such as: History of corner, with reference to Vol. and pg, dates, surveyor; exact description of monument replaced; if location computed, by taped or EDM traverse; landowner remarks, etc.

Excavated area with backhoe and found point of old wood post. This point was monumented and used to establish south ~~west~~ east corner of the section. This point is on a straight line equidistant between section corners.

OK 1 MAR 94 CR-JG
COR. OK 11-30-78 RN-DA

OK 4-12-84 SS-DK
OK 11-28-88 SS

2-GONE, 2-NEW, TOP BROKEN OFF MON., 2-10-98 - JG
2-NEW, 12-31-02 - JG

CERTIFIED CORRECT:

Anthony B. Kiedrowski
 Registered Land Surveyor
 DATE: 12-19-73

TIE SKETCH

(Show at least four ties)

1 New 1-28-09 SS

