
# PUBLIC LAND SURVEY MONUMENT RECORD

**HARRISON** TYPE OF MONUMENT: ADAMS COUNTY COORDINATES, NAD 83 (2005) N. 266375.700 E. 522826.414 **ELEVATION-**\_ DATUM\_ 10/22/2019 FIELD WORK DATE:


#### BASIS FOR MONUMENT LOCATION

1973 - PLS 878 SET ON A STRAIGHT LINE EQUIDISTANT BETWEEN SECTION CORNERS. EXCAVATED ENTIRE ROADWAY OPPOSITE TWO DIFFERENT FENCE LINES BUT FOUND NO EVIDENCE OF CORNER. (USED BACKHOE)

2019 - PLS 2675 FOUND A HARRISON MONUMENT 4" BELOW THE ROAD SURFACE AND 2 TIES. THE MONUMENT AGREES WITH THE EXISTING TIES. ACCEPTED THE HARRISON MONUMENT AS THE CORNER LOCATION. SET 2 NEW TIES AND MEASURED TO THE TIES.

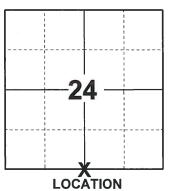

(INDICATE CORNER BY "X")

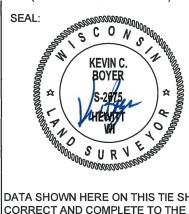

DATA SHOWN HERE ON THIS TIE SHEET IS CORRECT AND COMPLETE TO THE BEST OF MY KNOWLEDGE AND BELIEF.


PROFESSIONAL LAND SURVEYOR

#### -TIE SKETCH

NOTE: THE CORNER FALLS 4' ± NORTH OF THE CENTERLINE OF BROWNDEER AVE.



- SET 3/4" x 18" IRON REBAR, 1.50#/FT
- FOUND 3/4" IRON ROD
- FOUND 1-1/4" O.D. IRON PIPE
- FOUND HARRISON MONUMENT
- STEEL FENCE POST
- VINYL "T" POST

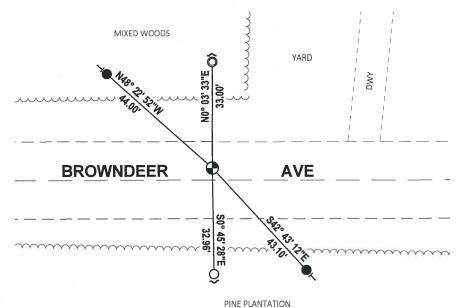

# ADAMS COUNTY

# Survey Monument Record

TYPE OF MONUMENT: <u>30° MARAISON</u>
STATE PLANE COORDINATES: N\_\_\_\_\_


ELEVATION — M.S.L. DATUM: \_\_\_\_\_\_THETA ANGLE: \_\_\_\_\_

## BASIS FOR MONUMENT LOCATION

(Use reverse side if necessary)

Show info such as: History of corner, with reference to Vol. and pg, dates, surveyor; exact description of monument replaced; if location computed, by taped or EDM traverse; landowner remarks, etc.

Set on a straight line equidistant between section corners. Excavated entire roadway opposite two different fence lines but found no evidence of corner. (used backhoe)

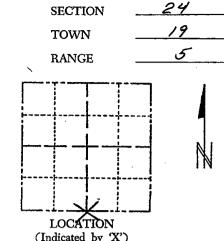

CORNER NO. \_

SEAL:



COR OK 11-30-78 RN-DA

OK 4-12-84 SS-DK

OK 11-28-88 55

THREE NEW TIES 2-14-94 CR - JG

OK, 2-10-98-JG

I-GONE 4-LEFT, 12-31-62-JG

CERTIFIED CORRECT:

ALCONOMICS Surveyor

DATE: 12-19-73

1

### TIE SKETCH

(Show at least four ties)

OK 1-28-07 SS

CHONE 94

STORE OF THE STORE OF

GONE 94

THEK
PINE OF

I TP Q POLE
WASTIG 1
CAP 15

Q BROWNDEER

PUE,

SONE 87

STUMP NAIL STILLGOOD)

7 NORWAY PINE