24 SECTION

TOWN

# OF ADAMS COUNTY

COUNTY CORNER NO: 93

ROMPORTOL ID: 41905240000


# PUBLIC LAND SURVEY MONUMENT RECORD

TYPE OF MONUMENT: HARRISON ADAMS COUNTY COORDINATES, NAD 83 (2007) N. **266381.308** E. 525414.738 DATUM\_\_\_\_\_ FIELD WORK DATE: 01/16/2018


#### BASIS FOR MONUMENT LOCATION

1973 - PLS 878 THE LOCATION WAS DETERMINED AFTER ANALYZING A TRAVERSE OF THE ENTIRE SECTION USING COMPUTED COORDINATES. THE EAST LINE OF THE NE 1/4 WAS EXTENDED AND DOUBLED. SET A HARRISON MONUMENT AT THE CALCULATED LOCATION AND TIED OUT.

2018 - PLS 2994 FOUND A HARRISON MONUMENT 3" BELOW THE ROAD SURFACE AND 1 PROPERTY IRON SET 33' TO THE NORTH. THE MONUMENT AGREES WITH THE EXISTING PROPERTY IRON. ACCEPTED THE HARRISON MONUMENT AS THE CORNER LOCATION. SET 3 NEW TIES AND MEASURED TO THE TIES AND PROPERTY IRON.

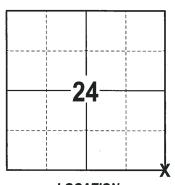

LOCATION (INDICATE CORNER BY "X")

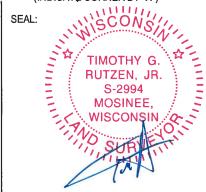

DATA SHOWN HERE ON THIS TIE SHEET IS CORRECT AND COMPLETE TO THE BEST OF MY KNOWLEDGE AND BELIEF.


PROFESSIONAL LAND SURVEYOR

3-1-18 DATE

#### - TIE SKETCH

NOTE: THE CORNER FALLS 3'± NORTH OF THE CENTERLINE OF BROWNDEER AVE AND 41'± EAST OF THE CENTERLINE LINE OF DEAD HORSE CREEK.



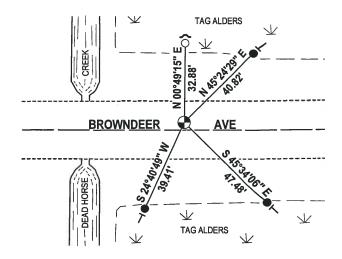

- 3/4" x 18" IRON REBAR SET, 1.50#/FT
- O 3/4" IRON ROD FOUND 🕀 HARRISON FOUND
- ✓ STEEL FENCE POST → VINYL "T" POST

## ADAMS COUNTY

### Survey Monument Record

TYPE OF MONUMENT: 30" MARRISON STATE PLANE COORDINATES: N.

ELEVATION — M.S.L. DATUM: \_

THETA ANGLE: \_

FIELD BOOK: \_\_\_\_ 

### BASIS FOR MONUMENT LOCATION

(Use reverse side if necessary)

Show info such as: History of corner, with reference to Vol. and pg, dates, surveyor; exact description of monument replaced; if location computed, by taped or EDM traverse; landowner remarks, etc.

Determined location after analizing a traverse of entire section, using computed coords. The east line of the NE 1/4 was extended and doubled.

RN-DA COR OK 11-30-78

Ok 4-12-84 SS-DK

OK- 11-28-55 55 ZNEW TIES Z-14-94 CR-JG

2-NEW TIES 4-10-98- JG-SS

1-GONE, 1-NEW, MON. OK, 12-31-02-56

CORNER NO. \_3/3 SECTION **TOWN** سی RANGE LOCATION

SEAL:

CERTIFIED CORRECT: 12-19-73 DATE: .

TIE	SKETCH

(Show at least four ties) OK 1-28-09 SS

