OS ADAMS COUNTY COUNTY COUNTY CORNER NO: 103

ROMPORTOL ID: 41905300000

PUBLIC LAND SURVEY MONUMENT RECORD


HARRISON TYPE OF MONUMENT: ADAMS COUNTY COORDINATES, NAD 83 (2005) N. **261077.703** E. 499033.960 ELEVATION-_ - - -DATUM - -FIELD WORK DATE:___ 12/19/2019

BASIS FOR MONUMENT LOCATION

1971 - PLS 981 FOUND AN IRON PIPE AND SET A HARRISON MONUMENT IN ITS PLACE.

2010 - PLS 1473 FOUND A HARRISON MONUMENT BURIED 0.5' UNDER THE SURFACE, SET A 5" GALVANIZED LANDSCAPING SPIKE OVER THE TOP OF THE MONUMENT.

2019 - PLS 2675 FOUND HARRISON 12" BELOW THE ROAD SURFACE AND 4 TIES. THE MONUMENT AGREES WITH 3 OF THE 4 TIES (BELIEVE NW TIE HAS BEEN DISTURBED). ACCEPTED THE HARRISON AS THE CORNER LOCATION AND MEASURED TO THE TIES.

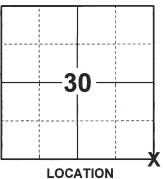

(INDICATE CORNER BY "X")




DATA SHOWN HERE ON THIS TIE SHEET IS CORRECT AND COMPLETE TO THE BEST OF MY KNOWLEDGE AND BELIEF.

PROFESSIONAL LAND SURVEYOR

-TIE SKETCH

NOTE: THE CORNER LANDS ON CENTERLINE OF CTH "Z" AND 0.5'± SOUTH OF BUTTERCUP AVE.



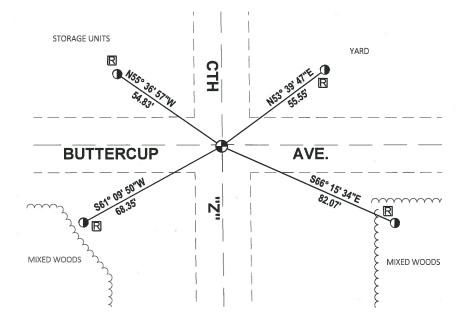

- FOUND 5/8" IRON ROD
- FOUND HARRISON MONUMENT
- R\W POST

U.S PUBLIC LAND SURVEY MONUMENT RECORD ADAMS COUNTY, WISCONSIN

TYPE OF MONUMENT: 5" GALVANIZED LANDSCAPING SPIKE OVER HARRISON MON. ADAMS COUNTY COORDINATES:


NORTH: 261077.71' EAST: 499034.02'

ELEVATION _ MSL DATUM: NOT APPLICABLE

THETA ANGLE: NOT APPLICABLE

FIELD BOOK:

DRAWN BY: DANIEL MARKS

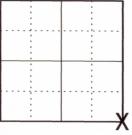

SECTION 30

TOWN 19 N RANGE 5 E

LOCATION

BASIS FOR MONUMENT LOCATION

On November 17, 1971 Sam T. Mullen found an iron pipe and set a Harrison monument in its place. Corner was buried 0.5' under the surface so I set a 5" galvanized landscaping spike over the top of the monument.





DATA SHOWN HEREON CERTIFIED CORRECT:

Jul (Man L

REGISTERED LAND SURVEYOR DATE: August 1, 2010

ALL WITNESS TIES ARE 5/8"
IRON RODS AT RW POSTS

BUTTERCUP

MAINTENANCE RECORD
DATE INIT. REMARKS

S 89°42'48" W

135.03'

12

135.03'

135.03'