

26
SECTION

19
TOWN

05
RANGE

ADAMS COUNTY

COUNTY CORNER NO: 111

ROMPORTOL ID: 41905260000

PUBLIC LAND SURVEY MONUMENT RECORD

TYPE OF MONUMENT: HARRISON
ADAMS COUNTY COORDINATES, NAD 83 (2005)

N. 261089.525

E. 520275.450


ELEVATION- DATUM

FIELD WORK DATE: 10/28/2019

BASIS FOR MONUMENT LOCATION

1971 - PLS 981 FOUND TWO NAILS AND IRON PIPE ON TOP OF EACH OTHER. SET A HARRISON MONUMENT.

2019 - PLS 2675 FOUND A HARRISON MONUMENT 10" BELOW THE ROAD SURFACE, 2 TIES AND 2 WITNESSES. THE MONUMENT AGREES WITH THE EXISTING TIES AND WITNESSES. ACCEPTED THE HARRISON MONUMENT AS THE CORNER LOCATION. SET 2 NEW TIES AND MEASURED TO THE EXISTING TIES AND WITNESSES.

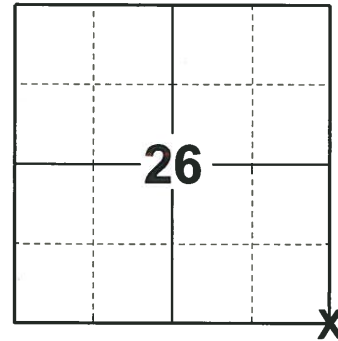

LOCATION

(INDICATE CORNER BY "X")

SEAL:





DATA SHOWN HERE ON THIS TIE SHEET IS CORRECT AND COMPLETE TO THE BEST OF MY KNOWLEDGE AND BELIEF.

PROFESSIONAL LAND SURVEYOR

DATE 11/25/19

- TIE SKETCH

NOTE: THE CORNER FALLS 14' ± WEST OF THE CENTERLINE OF 15TH AVE AND 32' ± NORTH OF THE CENTERLINE OF BUTTERCUP AVE.

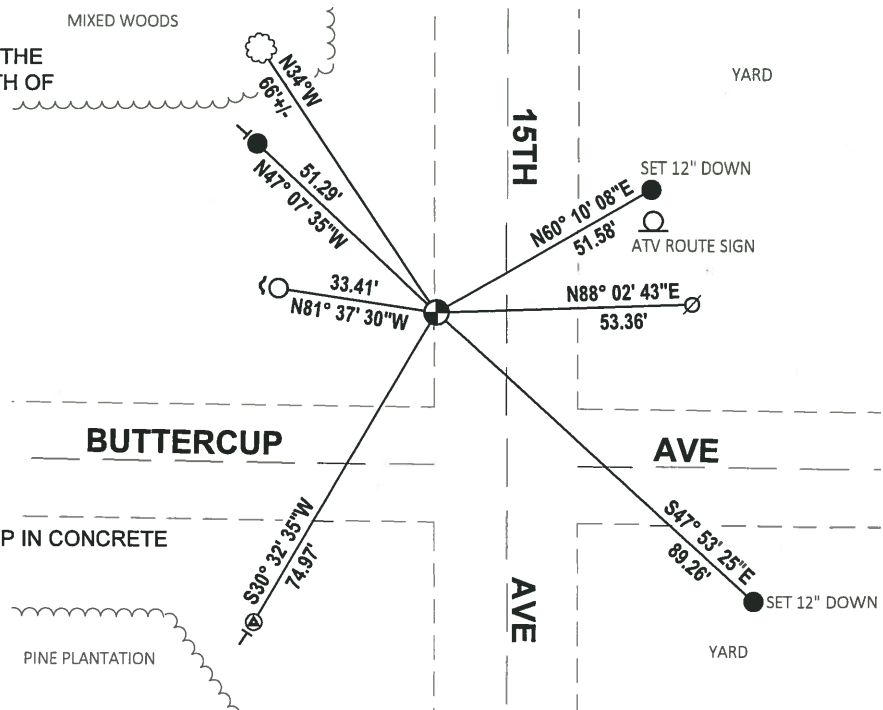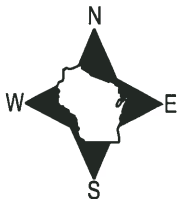

- SET 3/4" x 18" IRON REBAR, 1.50#/FT
- FOUND 3/4" IRON ROD
- ⊙ FOUND ADAMS COUNTY ALUMINUM CAP IN CONCRETE
- ⊕ FOUND HARRISON MONUMENT
- ⊗ WITNESS POWER POLE
- ┌ STEEL FENCE POST
- └ VINYL "T" POST
- ⊗ WITNESS TREE

ADAMS COUNTY

Survey Monument Record

TYPE OF MONUMENT: 30" HARRISON

STATE PLANE COORDINATES: N


E

ELEVATION — M.S.L. DATUM:

THETA ANGLE:

FIELD BOOK: 104 PAGE 33

CORNER NO. 1
SECTION 26
TOWN 19
RANGE 5

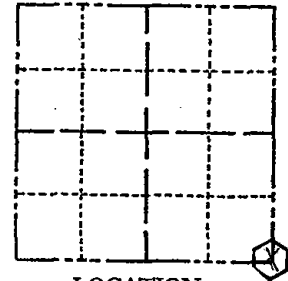

LOCATION (Indicated by 'X')

SEAL:

BASIS FOR MONUMENT LOCATION

(Use reverse side if necessary)

Show info such as: History of corner, with reference to Vol. and pg, dates, surveyor; exact description of monument replaced; if location computed, by taped or EDM traverse; landowner remarks, etc.

Found two nails and iron pipe on top of each other set monument

July 2, 1971.

Sam T. Mullem R.L.S. S-981

OK-1-14-09 SS
COR OK 11-30-79 RN-DA

OK 3-21-84 SS
11-22-88 G.R.-J.R. (1 NEW TIE)

OK 2-14-94 CE-JK

OK 2-10-98 JG

1-60-NE, 2-NEW, MON, OK, 1-02-03-JG

TIE MADE 11-22-88


CERTIFIED CORRECT:

Registered Land Surveyor

DATE:

TIE SKETCH

(Show at least four ties)

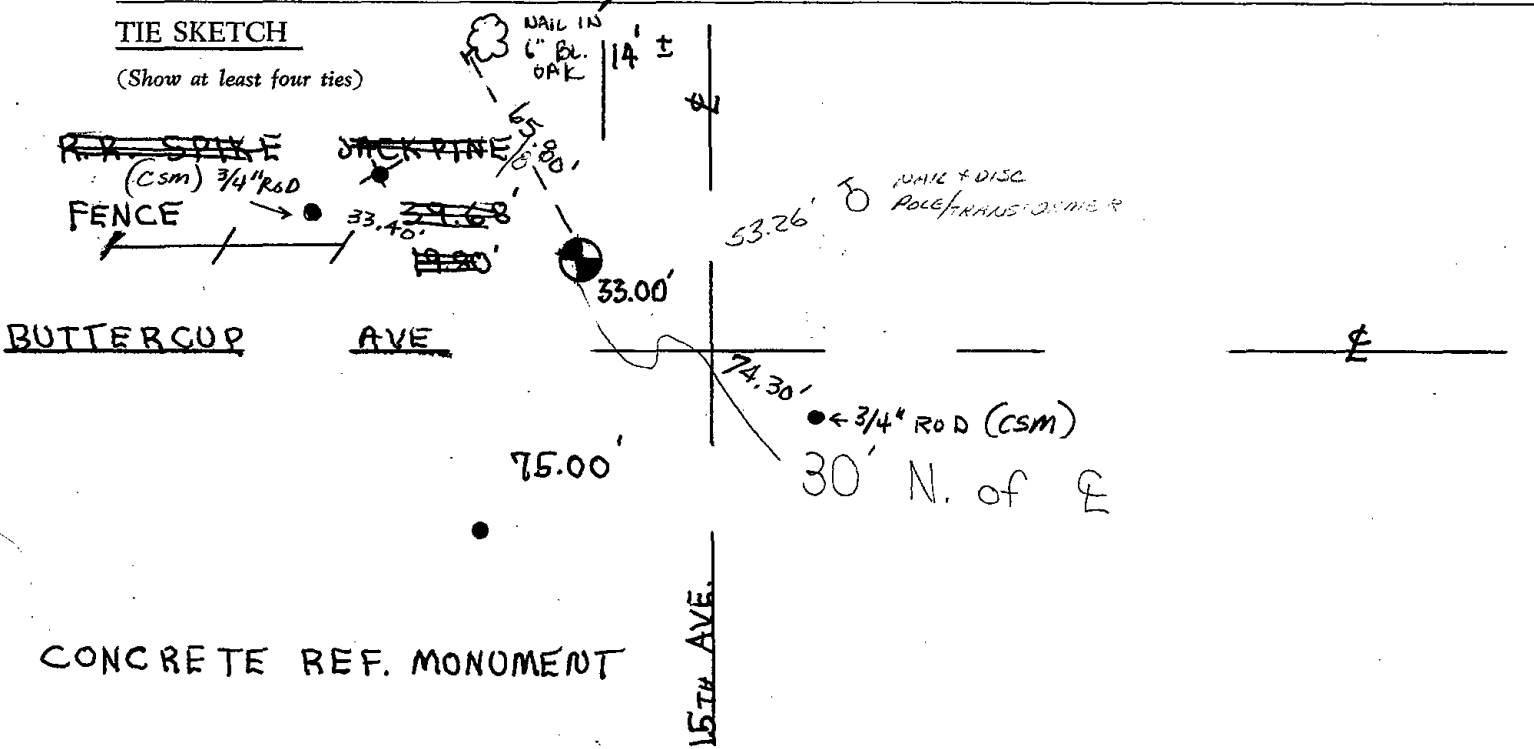

CONCRETE REF. MONUMENT