19 TOWN

05 RANGE

ADAMS COUNTY COUNTY COUNTY CORNER NO: 115

ROMPORTOL ID: 41905312000

PUBLIC LAND SURVEY MONUMENT RECORD

HARRISON (BROKEN-TOP) TYPE OF MONUMENT:

ADAMS COUNTY COORDINATES, NAD 83 (2005)

N. 258437.666

E. 499070.081

ELEVATION- - - -

DATUM - - -


FIELD WORK DATE: 12/19/2019

BASIS FOR MONUMENT LOCATION


1974 - PLS 1103 SET A HARRISON MONUMENT AT EQUAL DISTANCE BETWEEN THE NORTHWEST AND SOUTHWEST CORNERS OF SECTION 32.

2010 - PLS 1473 FOUND HARRISON BURIED 1.9' UNDER THE SURFACE, SET A 5" GALVANIZED LANDSCAPING SPIKE OVER THE TOP OF THE HARRISON MONUMENT.

2019 - PLS 2675 FOUND SPIKE IN THE ROAD SURFACE, REMOVED, AND FOUND HARRISON (BROKEN-TOP) 30" BELOW, AND 2 TIES (SOUTHERLY TIE LIES UNDER 3-4" OF WATER). THE MONUMENT AGREES WITH BOTH TIES. ACCEPTED THE HARRISON (BROKEN-TOP) AS THE CORNER LOCATION. SET 2 NEW TIES AND MEASURED TO THE EXISTING TIES.

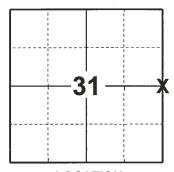

LOCATION (INDICATE CORNER BY "X")

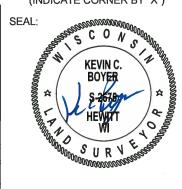


DATA SHOWN HERE ON THIS TIE SHEET IS CORRECT AND COMPLETE TO THE BEST OF MY KNOWLEDGE AND BELIEF.

PROFESSIONAL LAND SURVEYOR


2070

-TIE SKETCH

NOTE: THE CORNER LANDS 3'± EAST OF CENTERLINE OF CTH "Z".

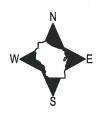

- SET 3/4" x 18" IRON REBAR, 1.50#/FT
- FOUND 3/4" IRON ROD
- FOUND HARRISON (BROKEN-TOP) MONUMENT
- STEEL FENCE POST
- VINYL "T" POST

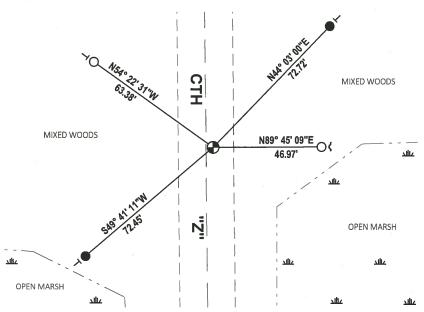

115

U.S PUBLIC LAND SURVEY MONUMENT RECORD ADAMS COUNTY, WISCONSIN

TYPE OF MONUMENT: 5" GALVANIZED LANDSCAPING SPIKE OVER HARRISON MON. ADAMS COUNTY COORDINATES:

NORTH: 258437.75' EAST: 499070.04'


ELEVATION _ MSL DATUM: NOT APPLICABLE

THETA ANGLE: NOT APPLICABLE

FIELD BOOK:

DRAWN BY: DANIEL MARKS

CORNER NO. 492 SECTION 32 TOWN 19 N RANGE 5 E

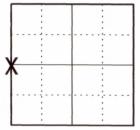

LOCATION

BASIS FOR MONUMENT LOCATION

On August 3, 1974 Dale C. Hagen set a Harrison monument at equal distance between the northwest and southwest corners of Section 32. Corner was buried 1.9' under the surface so I set a 5" galvanized landscaping spike over the top of the monument.





DATA SHOWN HEREON CERTIFIED CORRECT:

In L (Man L

REGISTERED LAND SURVEYOR DATE: August 1, 2010

TIE SKETCH: No Scale

SIGN

N 81°38'14" W

N 81°38'14" W

92.66'

N 81°38'14" W

92.66'

MAINTENANCE RECORD		
DATE IN	IT. REMARKS	
		── ○ 3/4" IRON ROD SET
		5/8" IRON ROD FOUND BY RW POST
		SIGN