

PUBLIC LAND SURVEY MONUMENT RECORD

TYPE OF MONUMENT: HARRISON
 ADAMS COUNTY COORDINATES, NAD 83 (2005)

N. 258450.666
 E. 520272.421


ELEVATION- - - - - DATUM - - - - -

FIELD WORK DATE: 11/11/2019

BASIS FOR MONUMENT LOCATION


1980 - PLS 1478 SET MONUMENT EQUIDISTANT AND ON LINE BETWEEN ADJACENT SECTION CORNERS. EXCAVATION WITH BACKHOE YIELDED NO EVIDENCE OF ANY PREVIOUS MONUMENTATION. NO EVIDENCE OF BEARING TREES ON FILE BY M.C. SMITH COULD BE FOUND.

2019 - PLS 2675 FOUND HARRISON MONUMENT 2"± BELOW THE ROAD SURFACE, 1 TIE, AND 3 WITNESSES. THE MONUMENT AGREES WITH ALL THE TIES AND WITNESSES. ACCEPTED THE HARRISON AS THE CORNER LOCATION. SET 3 NEW TIES AND MEASURED TO THE EXISTING TIE AND WITNESSES.

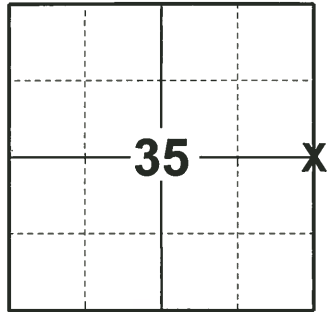

LOCATION
 (INDICATE CORNER BY "X")

SEAL:

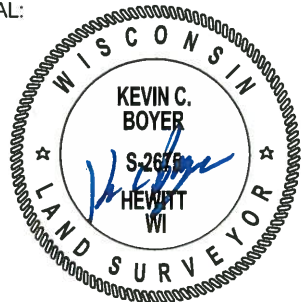

DATA SHOWN HERE ON THIS TIE SHEET IS CORRECT AND COMPLETE TO THE BEST OF MY KNOWLEDGE AND BELIEF.

PROFESSIONAL LAND SURVEYOR


DATE 1/9/2020

- TIE SKETCH

NOTE: THE CORNER FALLS 2"± WEST OF 15TH AVE CENTERLINE.



- SET 3/4" x 18" IRON REBAR, 1.50#/FT
- FOUND 3/4" IRON ROD
- ⊕ FOUND HARRISON MONUMENT
- ⊗ WITNESS POWER POLE
- ~ STEEL FENCE POST
- VINYL "T" POST
- ⊗ WITNESS TREE

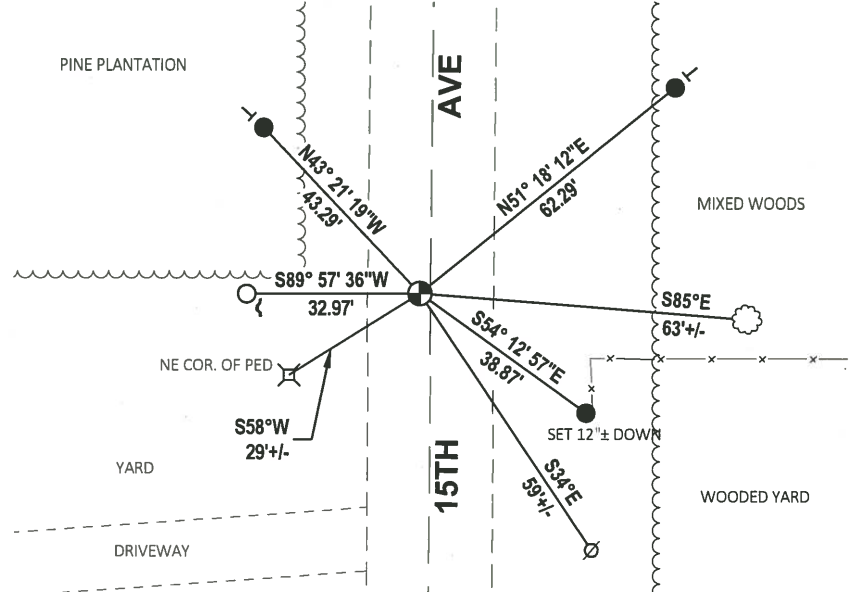


Government Land Corner Certificate

SET HDR
4/21/80
P. 11-22

CORNER NO. 119
SECTION 35
TOWN 19
RANGE 5

Adams County
TYPE OF MONUMENT: HARRISON STANDARD *Temp (OK) to be replaced*
STATE PLANE COORDINATES: N _____ E _____
ELEVATION — M.S.L. DATUM: _____
THETA ANGLE: _____
FIELD BOOK: 83 PAGE 5B
DRAWN BY: G. RHINEHART

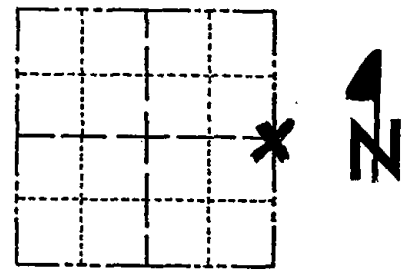

LOCATION
(Indicated by 'X')

BASIS FOR MONUMENT LOCATION

Show info such as: History of corner, with reference to Vol. and pg., dates, surveyor; exact description of monument replaced; if location computed, by taped or EDM traverse; landowner remarks, etc. (Use reverse side if necessary)

Set monument equidistant and on line between adjacent section corners. Excavation with backhoe yielded no evidence of any previous monumentation. No evidence of bearing trees on file by M. C. Smith could be found.

SEAL:



DATA SHOWN HEREON
CERTIFIED CORRECT:

Gregory P. Rhinehart
Registered Land Surveyor

DATE: 4/21/80

Ok 3-21-84 SS
OK 2-14-94 CR-JG
1-GONE, 2-NEW, MON. OK, 2-10-98-JG
OK 1-02-03-JG
OK 1-14-09 SS

TIE SKETCH

Show at least four ties, also fence lines, roads, topo, size and type of witness trees' and if off road - best way to arrive at corner.

