OS ADAMS COUNTY

COUNTY CORNER NO: 129

ROMPORTOL ID: 41905340000

PUBLIC LAND SURVEY MONUMENT RECORD

HARRISON (BROKEN-TOP) TYPE OF MONUMENT: ADAMS COUNTY COORDINATES, NAD 83 (2007) N. **255801.744** E. 514973.696 ELEVATION-DATUM --FIELD WORK DATE: 01/15/2018


BASIS FOR MONUMENT LOCATION

2014 - PLS 2443 STATES THAT THE LAST TIE SHEET ON FILE FOR THIS CORNER IS DATED JANUARY 8, 1980 BY GREGORY P. RHINEHART, R.L.S. 1478. RHINEHART STATES HE SET A HARRISON MONUMENT AT THIS CORNER BY SINGLE PROPORTIONATE MEASUREMENT AND ON A LINE BETWEEN THE SW CORNER OF SECTION 34 AND THE SE CORNER OF SECTION 35. NUMEROUS NOTATIONS BY OTHER SURVEYORS ALSO APPEAR ON THE TIE SHEET. THE STANDARD HARRISON CAST IRON MONUMENT WAS AT THE CORNER LOCATION AS NOTED BY RHINEHART, ESTABLISHED REFERENCE TIES TO PERPETUATE THE CORNER LOCATION.

2018 - PLS 2994 FOUND A HARRISON MONUMENT WITH A BROKEN-TOP 6" BELOW THE ROAD SURFACE AND 2 WITNESSES. THE MONUMENT AGREES WITH THE EXISTING WITNESSES. ACCEPTED THE HARRISON MONUMENT WITH A BROKEN-TOP AS THE CORNER LOCATION. SET 4 NEW TIES AND MEASURED TO THE TIES AND WITNESSES.



(INDICATE CORNER BY "X")

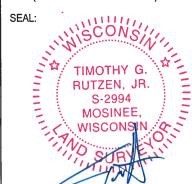

DATA SHOWN HERE ON THIS TIE SHEET IS CORRECT AND COMPLETE TO THE BEST OF MY KNOWLEDGE AND BELIEF.


PROFESSIONAL LAND SURVEYOR

- TIE SKETCH

NOTE: THE CORNER FALLS 10'± NORTH OF THE CENTERLINE OF CHICAGO AVE AND 13'± EAST OF THE CENTERLINE OF 16TH AVE.



 3/4" x 18" IRON REBAR SET, 1.50#/FT THE HARRISON (BROKEN-TOP) FOUND WITNESS "T" POST FOUND → VINYL "T" POST WITNESS TREE FOUND

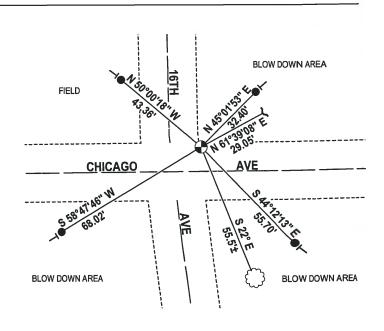

ADAMS COUNTY SURVEY MONUMENT RECORD

TYPE OF MONUMENT: STD. HARRISON CAST IRON ADAMS COUNTY COORDINATES: N = 255,801.72

E = 514,973.75

DATUM: NAD '83/2007 ADJ.-GPS AND CONVENTIONAL CONTROL

WITNESSES TO CORNER LOCATION: TODD T. RUMMLER, MARK A. MAHONEY

BASIS FOR MONUMENT LOCATION

SHOW INFO SUCH AS: HISTORY OF CORNER, WITH REFERNCE TO VOL. AND PG., DATES, SURVEYOR; EXACT DESCRIPTION OF MONUMENT REPLACED; IF LOCATION COMPUTED, BY TAPED OR EDM TRAVERSE; LANDOWNER REMARKS, ETC.

THE LAST TIE SHEET ON FILE FOR THIS CORNER IS DATED JANUARY 8, 1980 BY GREGORY P. RHINEHART, R.L.S. 1478. RHINEHART STATES HE SET A HARRISON MONUMENT AT THIS CORNER BY SINGLE PROPORTIONATE MEASUREMENT AND ON LINE BETWEEN THE SW CORNER OF SECTION 34 AND THE SE CORNER OF SECTION 35. NUMEROUS NOTATIONS BY OTHER SURVEYORS ALSO APPEAR ON THE TIE SHEET. I FOUND THE STANDARD HARRISON CAST IRON MONUMENT AS NOTED BY RHINEHART AND ESTABLISHED REFERENCE TIES AS SHOWN BELOW TO PERPETUATE THE CORNER LOCATION.

CORNER No. 129

SECTION 34

