

35 SECTION 19 TOWN 05 RANGE

ADAMS COUNTY

COUNTY CORNER NO: 130
ROMPORTOL ID: 41905350020

PUBLIC LAND SURVEY MONUMENT RECORD

TYPE OF MONUMENT: HARRISON
ADAMS COUNTY COORDINATES, NAD 83 (2007)

N. 255806.880

E. 517621.794


ELEVATION- --- DATUM ---

FIELD WORK DATE: 01/15/2018

BASIS FOR MONUMENT LOCATION


1980 - PLS 1478 EXCAVATION WITH A BACKHOE AT THIS LOCATION REVEALED NO EVIDENCE OF ANY PREVIOUS MONUMENTATION. SET THE CORNER PROPORTIONATE AND ON A LINE BETWEEN THE S1/4 CORNER OF SECTION 34-19-5 AND THE SE CORNER OF SECTION 35-19-5 AND TIED OUT.

2018 - PLS 2994 FOUND A HARRISON MONUMENT 10" BELOW THE ROAD SURFACE AND 4 WITNESS TREES. THE MONUMENT AGREES WITH THE EXISTING WITNESS TREES. ACCEPTED THE HARRISON MONUMENT AS THE CORNER LOCATION. SET 4 NEW TIES AND MEASURED TO THE TIES AND WITNESS TREES.

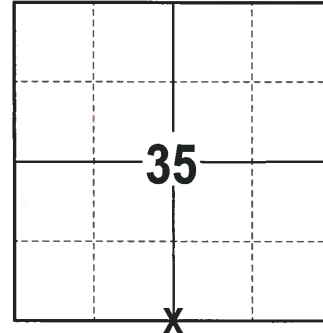

LOCATION
(INDICATE CORNER BY "X")

SEAL:

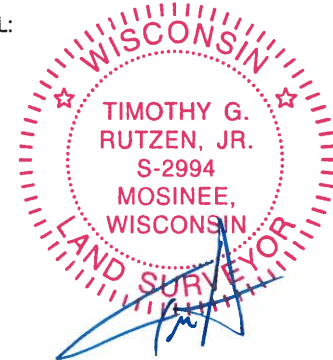



DATA SHOWN HERE ON THIS TIE SHEET IS CORRECT AND COMPLETE TO THE BEST OF MY KNOWLEDGE AND BELIEF.

PROFESSIONAL LAND SURVEYOR


DATE 3-1-18

- TIE SKETCH

NOTE: THE CORNER FALLS 2± NORTH OF THE CENTERLINE OF CHICAGO AVE.

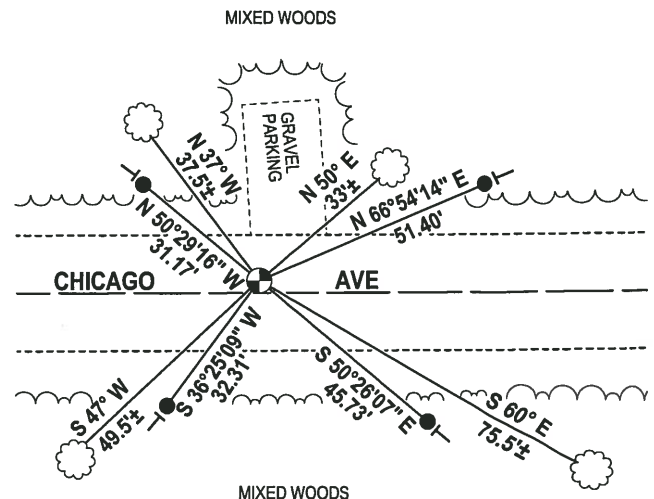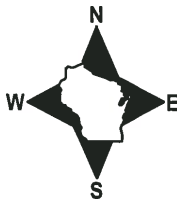

 - 3/4" x 18" IRON REBAR SET, 1.50#/FT
- ⊙ HARRISON FOUND
- VINYL "T" POST
- ☼ WITNESS TREE FOUND



Government Land Corner Certificate

HAB. SET
4/21/80
RN-SS

CORNER NO. 130
SECTION 35
TOWN 19
RANGE 5

ADAMS County

TYPE OF MONUMENT: HARRISON STANDARD *Terminal CR stake hole*


STATE PLANE COORDINATES: N _____
E _____

ELEVATION — M.S.L. DATUM: _____

THETA ANGLE: _____

FIELD BOOK: 83 PAGE 59

DRAWN BY: G. RHINEHART

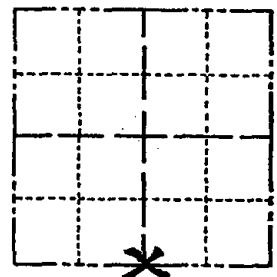

BASIS FOR MONUMENT LOCATION

Show info such as: History of corner, with reference to Vol. and pg., dates, surveyor; exact description of monument replaced; if location computed, by taped or EDM traverse; landowner remarks, etc. (Use reverse side if necessary)

line

Set corner proportionate and on Δ between the $S\frac{1}{2}$ corner of Section 34-19-5 and the SE corner of Section 35-19-5. Excavation with backhoe at this location revealed no evidence of any previous monumentation.

SEAL:



DATA SHOWN HERE ON CERTIFIED CORRECT:

Gregory P. Rhinehart
Registered Land Surveyor

DATE: 1/21/80

Ok 3-21-84 SS
OK 2-14-94 CR-JG
2-GONE, 2-NEW, MON. OK, 2-10-98-JG
1-GONE, 1-NEW, MON. OK, 1-02-03-JG

TIE SKETCH

Show at least four ties, also fence lines, roads, topo, size and type of witness trees and if off road - best way to arrive at corner.

