OF ADAMS COUNTY

COUNTY CORNER NO: 125

ROMPORTOL ID: 42006320000

PUBLIC LAND SURVEY MONUMENT RECORD

HARRISON (BROKEN-TOP) TYPE OF MONUMENT: ADAMS COUNTY COORDINATES, NAD 83 (2007)

N. **287592.884**

E. 536070.582

ELEVATION-

DATUM


FIELD WORK DATE:

02/07/2018

BASIS FOR MONUMENT LOCATION

1976 - PLS 1103 RAN EDM/TRANSIT TRAVERSE AROUND SECTIONS 4, 5 AND PARTS OF 3 AND 6 TO DETERMINE SEARCH AREAS. COULD NOT FIND ANY EVIDENCE OF THE ORIGINAL CORNER OR ANY REMONUMENTATION. CALCULATED THE CORNER PROPORTIONAL TO THE ORIGINAL NOTES BETWEEN THE NORTHWEST CORNER OF SECTION 6 AND THE NORTHEAST CORNER OF SECTION 4. SET A HARRISON MONUMENT AND TIED OUT.

2018 - PLS 2994 FOUND A HARRISON MONUMENT WITH A BROKEN-TOP 12" BELOW THE ROAD SURFACE. FOUND NO EVIDENCE OF ANY OF THE WITNESSES. ACCEPTED THE HARRISON MONUMENT WITH A BROKEN-TOP AS THE BEST EVIDENCE OF THE CORNER LOCATION. SET 4 NEW TIES AND MEASURED TO THE TIES.

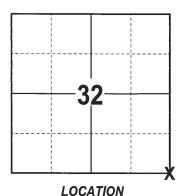

(INDICATE CORNER BY "X")

SEAL:



DATA SHOWN HERE ON THIS TIE SHEET IS CORRECT AND COMPLETE TO THE BEST OF MY KNOWLEDGE AND BELIEF.


PROFESSIONAL LAND SURVEYOR

DATE 3-1-18

- TIE SKETCH

NOTE: THE CORNER FALLS 8'± NORTH OF THE CENTERLINE OF BADGER AVE.



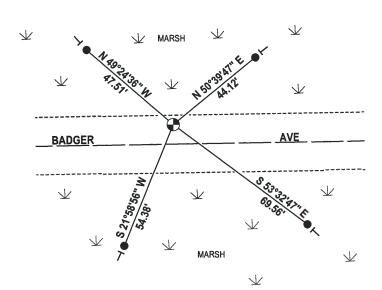

 3/4" x 48" IRON REBAR SET, 1.50#/FT THARRISON (BROKEN-TOP) FOUND

→ VINYL "T" POST

ADAMS COUNTY CORNER NO. SECTION Survey Monument Record 19 TYPE OF MONUMENT: Standard Harrison TOWN 6 RANGE STATE PLANE COORDINATES: N. ELEVATION - M.S.L. DATUM: _ THETA ANGLE: _ FIELD BOOK: ___ _ PAGE _ BASIS FOR MONUMENT LOCATION (Use reverse side if necessary) Show info such as: History of corner, with reference to Vol. and pg, dates, surveyor; exact description of monument replaced; if location computed, by taped or EDM traverse; landowner SEAL: Ran EDM/transit traverse around Sections 4, 5 and parts of 3 and 6 to determine search areas. Could find no evidence of the original corner or any remonumentation. Set corner proportional to original notes between the Northwest corner of Section 6 and the Northeast corner of Section 4. DA-SS 11-24-78 OK 6R-55 4-13-83 6R CERTIFIED CORRECT 1-26-88 J6-85 1-6-93 ALL OK Registered Land Surveyor OK, 2-12-98 -JG January 1976 DATE: OK 1-28-03-56 TIE SKETCH OK (Show at least four ties)

