06 SECTION

# ADAMS COUNTY COUNTY CORNER NO: 15 ROMPORTOL ID: 41906062000

# PUBLIC LAND SURVEY MONUMENT RECORD

**3/4" IRON ROD** TYPE OF MONUMENT: ADAMS COUNTY COORDINATES, NAD 83 (2007)

N. 284889.803

E. 530815.478

DATUM **ELEVATION-**


11/28/2018 FIELD WORK DATE:

#### BASIS FOR MONUMENT LOCATION

1975 - PLS 1103 RAN EDM/TRANSIT TRAVERSE AROUND SECTIONS 4, 5 AND 6 TO DETERMINE SEARCH AREAS FOR INVESTIGATION. FOUND NO EVIDENCE OF THE ORIGINAL CORNER OR ANY REMONUMENTATION. CALCULATED THE CORNER LOCATION ON LINE AND PROPORTIONATE TO ORIGINAL GOVERNMENT NOTES BETWEEN ADJACENT SECTION CORNERS. SET A HARRISON MONUMENT AT THE CALCULATED LOCATION AND TIED OUT.

1996 - PLS 1478 THIS CORNER WAS SET BY DALE HAGEN FOR KIEDROWSKI ENGINEERING INC. ON LINE AND AT PROPORTIONATE DISTANCE BETWEEN THE ADJACENT SECTION CORNERS, NEKOOSA PAPER CO. EMPLOYEES BROUGHT IT TO MY ATTENTION THAT THE CORNER WAS NOT SET CORRECTLY IN THE FIELD AND THAT THE SURVEYS IN THE AREA SEEMED TO FIT THE SECTION SUMMARY. I TRAVERSED THE SECTION AND FOUND THE MONUMENT TO HAVE BEEN SET ERRONEOUSLY BY 203.99 FEET. THIS TIE SHEET REFLECTS THE CORRECT LOCATION FOR THE MONUMENT

2018 - PLS 2675 FOUND A 3/4" IRON ROD 2" ABOVE THE GROUND SURFACE AND 4 WITNESS TREES. THE MONUMENT AGREES WITH THE EXISTING WITNESS TREES. ACCEPTED THE 3/4" IRON ROD AS THE CORNER LOCATION. SET 4 NEW TIES AND MEASURED TO THE TIES AND WITNESS TREES.

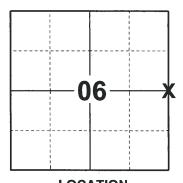

**LOCATION** 

(INDICATE CORNER BY "X")



DATA SHOWN HERE ON THIS TIE SHEET IS CORRECT AND COMPLETE TO THE BEST OF MY KNOWLEDGE AND BELIEF.

PROFESSIONAL LAND SURVEYOR

DATE\_ 1-18-19

#### -TIE SKETCH

NOTE: THE CORNER FALLS 105'± NORTHEAST OF THE CENTERLINE OF THE TRAIL.



PLANTATION

- SET 3/4" x 18" IRON REBAR, 1.50#/FT
- FOUND 3/4" IRON ROD
- VINYL "T" POST
- WITNESS TREE

# U.S PUBLIC LAND SURVEY MONUMENT RECORD ADAMS COUNTY, WISCONSIN


TYPE OF MONUMENT: HARRISON-STANDARD 3/4"ROD

STATE PLANE COORDINATES: N: NOT APPLICABLE E: NOT APPLICABLE

ELEVATION \_ MSL DATUM: NOT APPLICABLE

THETA ANGLE: NOT APPLICABLE FIELD BOOK: 55 PAGE 76 DRAWN BY: GREG RHINEHART

CORNER NO. 15 SECTION 6 TOWN 19N RANGE 6E

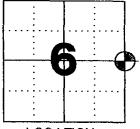

LOCATION

### BASIS FOR MONUMENT LOCATION


THIS CORNER WAS SET BY DALE HAGEN FOR KIEDROWSKI ENGINEERING INC. ON LINE AND AT PROPORTIONATE DISTANCE BETWEEN THE ADJACENT SECTION CORNERS. NEKOOSA PAPER CO. EMPLOYEES BROUGHT IT TO MY ATTENTION THAT THE CORNER WAS NOT SET CORRECTLY IN THE FIELD AND THAT THE SURVEYS IN THE AREA SEEMED TO FIT THE SECTION SUMMARY. I TRAVERSED THE SECTION AND FOUND THE MONUMENT TO HAVE BEEN SET ERRONEOUSLY BY 203.99 FEET. THIS TIE SHEET REFLECTS THE CORRECT LOCATION FOR THE MONUMENT.

SEAL



DATA SHOWN HEREON CERTIFIED CORRECT:

REGISTERED LAND SURVEYOR DATE: JANUARY 16, 1996

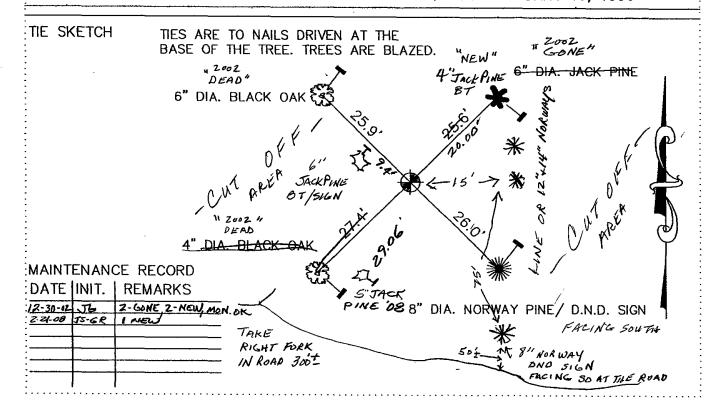

## ADAMS COUNTY

# Survey Monument Record

TYPE OF MONUMENT: Standard Harrison


STATE PLANE COORDINATES: N.

E.

ELEVATION — M.S.L. DATUM:

THETA ANGLE: \_

FIELD BOOK: \_\_\_ PAGE

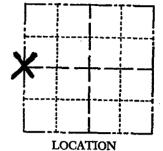

(Indicated by 'X')

CORNER NO.

SECTION

TOWN

RANGE

SEAL:

### BASIS FOR MONUMENT LOCATION

(Use reverse side if necessary)

Show info such as: History of corner, with reference to Vol. and pg, dates, surveyor; exact description of monument replaced; if location computed, by taped or EDM traverse; landowner remarks, etc.

Ran EDM/transit traverse around Sections 4, 5 and 6 to determine search areas for investigation.

Could find no evidence of the original corner or any remonumentation.

Set corner on line and proportionate to original government notes between adjacent section corners.

RETIED 11-29-78 RN-DA 6 R-SS 3-29-83 1-NEW TIE 1-7-93 JG-BS

CERTIFIED CORRECT:

Registered Land Surveyo DATE. December

TIE SKETCH

