# 06 RANGE ADAMS COUNTY COUNTY CORNER NO: 16 ROMPORTOL ID: 41906052000


## PUBLIC LAND SURVEY MONUMENT RECORD

**HARRISON** TYPE OF MONUMENT: ADAMS COUNTY COORDINATES, NAD 83 (2007) N. 284963.739 E. 536099.256 DATUM - -**ELEVATION-**11/28/2018 FIELD WORK DATE:


#### **BASIS FOR MONUMENT LOCATION**

1976 - PLS 1103 RAN EDM/TRANSIT TRAVERSE AROUND SECTIONS 4, 5 AND PORTIONS OF 3 AND 6 TO DETERMINE SEARCH AREAS. FOUND NO EVIDENCE OF THE ORIGINAL CORNER OR ANY REMONUMENTATION. CALCULATED THE CORNER LOCATION ON LINE AND PROPORTIONAL TO ORIGINAL NOTES BETWEEN ADJACENT SECTION CORNERS. SET A HARRISON MONUMENT AT THE CALCULATED LOCATION AND TIED OUT.

2018 - PLS 2675 FOUND A HARRISON MONUMENT 3" ABOVE THE GROUND SURFACE AND 3 WITNESS TREES. THE MONUMENT AGREES WITH THE EXISTING WITNESS TREES. ACCEPTED THE HARRISON MONUMENT AS THE CORNER LOCATION. SET 4 NEW TIES AND MEASURED TO THE TIES AND WITNESS TREES.

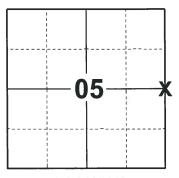

LOCATION (INDICATE CORNER BY "X")

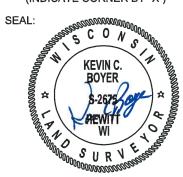

DATA SHOWN HERE ON THIS TIE SHEET IS CORRECT AND COMPLETE TO THE BEST OF MY KNOWLEDGE AND BELIEF.

PROFESSIONAL LAND SURVEYOR


1-18-19

#### -TIE SKETCH

NOTE: THE CORNER FALLS 48'± NORTH OF THE CENTERLINE OF THE TRAIL.



- SET 3/4" x 18" IRON REBAR, 1.50#/FT
- FOUND 1-1/4" x 5' O.D. IRON PIPE
- FOUND HARRISON MONUMENT
- VINYL "T" POST
- WITNESS TREE

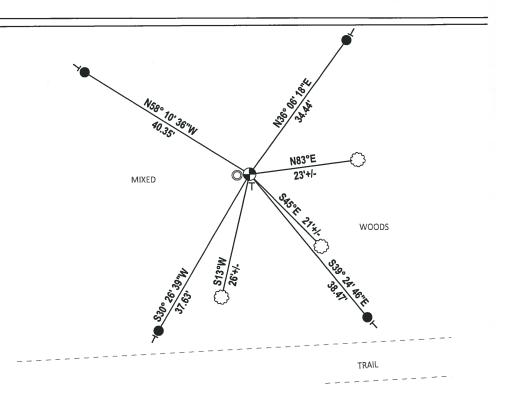

### CORNER NO. \_ ADAMS COUNTY SECTION Survey Monument Record TYPE OF MONUMENT: Standard Harrison TOWN **RANGE** STATE PLANE COORDINATES: N. ELEVATION - M.S.L. DATUM: . THETA ANGLE: \_ FIELD BOOK: \_\_ PAGE . BASIS FOR MONUMENT LOCATION (Use reverse side if necessary) LOCATION Show info such as: History of corner, with reference to Vol. and pg, dates, surveyor; exact description of monument replaced; if location computed, by taped or EDM traverse; landowner (Indicated by 'X') SEAL: Ran EDM/transit traverse around Sections 4, 5 and parts of 3 and 6, to determine search areas. Could find no evidence of the original corner DALE C. or any remonumentation. HAGEN S-1103 Wisconsin Rapids, Set corner on line and proportional to original Wis. notes between adjacent section corners. Corner Requesty RN-DA COR. OK 11-29-78 4-24.83 1-7-93 2-GONE, 2-NEW TIES ALL OK 4-10-98 JG-2 New TIES NOV'08 SS Registered Land Surveyo January DATE: TIE SKETCH (Show at least four ties) Ties in trees to nail in disc. DEAD 3" Jack Pine with 'n TER OF 5 2008 ES 5" BIK DND SIGN FACES TRAIL

REVISED 1974