05 SECTION

# 06 RANGE ADAMS COUNTY COUNTY CORNER NO: 24 ROMPORTOL ID: 41906050020

## PUBLIC LAND SURVEY MONUMENT RECORD

**COTTON GIN SPINDLE** TYPE OF MONUMENT: ADAMS COUNTY COORDINATES, NAD 83 (2007) N. 282290.244 E. 533480.583 **ELEVATION-**DATUM

11/28/2018


#### **BASIS FOR MONUMENT LOCATION**

FIELD WORK DATE:

1976 - PLS 1103 RAN EDM/TRANSIT TRAVERSE AROUND SECTIONS 4, 5 AND PORTIONS OF 3 AND 6 TO DETERMINE SEARCH AREAS. FOUND NO EVIDENCE OF THE ORIGINAL CORNER BECAUSE THE SEARCH AREA FELL WITHIN THE CONCRETE PAVEMENT OF STATE HIGHWAY 13. FOR THIS REASON NO EXCAVATION WAS ATTEMPTED. CALCULATED THE CORNER LOCATION BY RECONSTRUCTION FROM SURVEY BY SAM T. MULLEN IN THE NORTHWEST QUARTER OF SECTION 5. SET A HARRISON MONUMENT AT THE CALCULATED LOCATION AND TIED OUT.

2008 - PLS 1452 FOUND "PK" NAIL ON 9-8-2008, PRIOR TO 2008 RESURFACING PROJECT. SET NEW REFERENCE MONUMENTS (4" ALUMINUM DISKS SET IN CONCRETE) ON 10-2-2018. RE-SET SECTION CORNER ON 11-3-2008 AND MEASURED TO TIES.

2018 - PLS 2675 FOUND A COTTON GIN SPINDLE IN THE ROAD SURFACE AND 4 TIES. THE MONUMENT AGREES WITH THE EXISTING TIES, ACCEPTED THE COTTON GIN SPINDLE AS THE CORNER LOCATION AND RE-MEASURED TO THE EXISTING TIES.

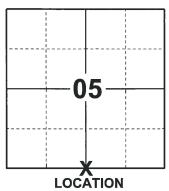

(INDICATE CORNER BY "X")




DATA SHOWN HERE ON THIS TIE SHEET IS CORRECT AND COMPLETE TO THE BEST OF MY KNOWLEDGE AND BELIEF.


PROFESSIONAL LAND SURVEYOR

DATE \_\_\_ 1-18-19

#### -TIE SKETCH -

NOTE: THE CORNER FALLS ON THE CENTERLINE OF STH 13 AND 1'± NORTH OF THE CENTERLINE OF BEAVER AVE.

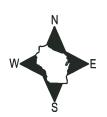

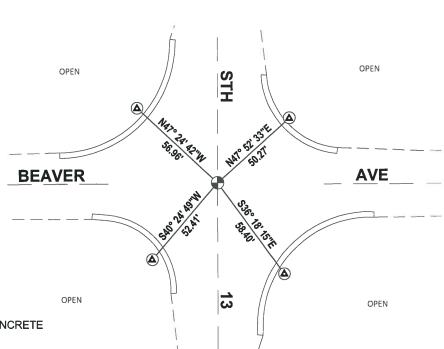

FOUND WISDOT ALUMINUM CAP IN CONCRETE

FOUND COTTON GIN SPINDLE

### **ADAMS COUNTY**

**Survey Monument Record** 

TYPE OF MONUMENT:	Berntsen Nail
STATE PLANE COORDINATES: N	
E	,
ELEVATION — M.S.L. DATUM:	
THETA ANGLE:	
FIELD BOOK:	PAGE
DRAWN BY: D. Christie	


#### **BASIS FOR MONUMENT LOCATION**

(Use reverse side if necessary)

Show info such as: History of corner, with reference to Vol. and pg, dates, surveyor, exact description of monument replaced; if location computed, by taped or EDM traverse; landowner remarks, etc.

Found "PK" nail on 9-8-2008, prior to 2008 Resurfacing Project. Set new reference monuments (4" Alum. Disks set in concrete) on 10-2-2008. Re-set section corner on 11-3-2008 and measured Ties.

SEE DAVE HAGEN TIE SHEET 01-17-76

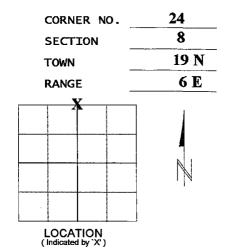

SEAL:




CERTIFIED/CORRECT:

Registered Land Survey

Date: 12-12-2008

#### TIE SKETCH

(Show at least four ties)

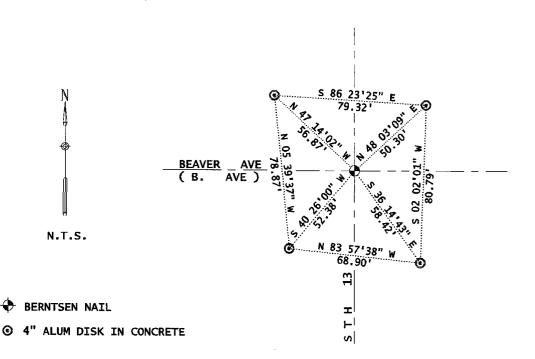

ADAMS COUNTY			CORNER NO.	With Company of the Party of
Survey Monument Record			SECTION *	Charles and Charles and Charles
TYPE OF MONUMENT, Railroad Spike wi	th Chisel Cr	OSS TOWN TO MAKE A	RANGE	A STATE OF THE STATE OF
STATE PLANE COORDINATES: N		The state of the s		
ELEVATION — M.S.L. DATUM:				Helling (Prince
THETA ANGLE: PAGE PAGE				en bester – Adi
BASIS FOR MONUMENT LOCATION	TO BELLEVIOLE			rate en la company
(Use reverse side if necessary)				
Show tafe such as: History of comer, with reference and pg. dates, surveyor, exact description of monument if location computed, by taped or EDM traverse; l	e w Vol		LOCATION (	
if location computed, by taped or EDM traverse; I remarks, etc.	andowner	SEAL	Market Control (N	
Carried Street Street			Manimus,	
Ran EDM/transit traverse around and parts of 3 and 6 to determin			STEENS	
	<b>10.00</b>		DALE C	New Arrest
Could find no evidence of the or because the search area fell wit	h the concret		HAGEN S-1103	Maria Park
pavement of State Highway 13. F no excavation was attempted.	or this reaso	n	Ter Wisconsin Replay	
Set corner by reconstruction fro Sam T. Mullen in the Northwest Q	m survey by		* ASIA	
Section 5.	p &			
OK 3-118		CHRYTTH	D CORRECT: #	4 F/W (841)
OK 2-1-81 G-		To de	CISS S.V.	
3-60NE, 4-NEW 2/24/98	Jeth	Registeral		A Committee of the Comm
TIE SKETCH OK, 11-14-07- 56-3	<b>,</b>	NOTE	i di Krevisia i N	+ president
(Show at least four ties)			s and poles i	
J RR SPK		nail in disc		
Powers /			格哥等的物學所	
SET AK. NAIL		Pasonory nail		N
END CONCRETES	, W	of disc of	Book Ble	A CONTRACTOR OF THE SECOND
BUTTERS	V. V.	e acces	The state of the s	
C Beaver		<del></del>		lue.
E 12-12-08		23.8>		
PORTE	0	8	Sign	
GNNIS CHRISTIE		2 2		
/_		0-//- <b>=</b> 0	n Ko	
/63/			0+52"x 30" I	on de
			<del></del>	1 1 1 1 1 1 1 1 1 1 1 1 1 1 1 1 1 1 1
6"81K. Oak 1000			0-=(1' N of	ROW. Post)