01 SECTION

ADAMS COUNTY COUNTY COUNTY CORNER NO: 32 ROMPORTOL ID: 41906010020


PUBLIC LAND SURVEY MONUMENT RECORD

HARRISON TYPE OF MONUMENT: ADAMS COUNTY COORDINATES, NAD 83 (2007) N. **282347.026** E. 554545.258 **ELEVATION-**DATUM 11/26/2018 FIELD WORK DATE:


BASIS FOR MONUMENT LOCATION

1980 - PLS 1478 CALCULATED THE CORNER LOCATION EQUIDISTANT AND ON LINE BETWEEN ADJACENT SECTION CORNERS. THIS LOCATION MATCHES A SURVEY TO THE EAST BY PERRY - CARRINGTON, INC. EXCAVATION WITH A BACKHOE YIELDED NO EVIDENCE OF ANY PREVIOUS MONUMENTATION. SET A HARRISON MONUMENT AT THE CALCULATED LOCATION AND TIED OUT.

2018 - PLS 2675 FOUND A HARRISON MONUMENT 6" BELOW THE ROAD SURFACE, 1 TIE, 1 PROPERTY IRON AND 1 WITNESS. THE MONUMENT AGREES WITH THE EXISTING TIE AND WITNESS. ACCEPTED THE HARRISON MONUMENT AS THE CORNER LOCATION. SET 3 NEW TIES AND MEASURED TO THE TIES, PROPERTY IRON AND WITNESS.

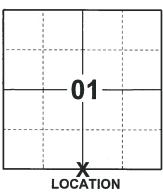

(INDICATE CORNER BY "X")

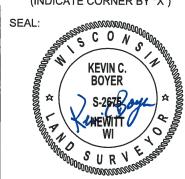

DATA SHOWN HERE ON THIS TIE SHEET IS CORRECT AND COMPLETE TO THE BEST OF MY KNOWLEDGE AND BELIEF.

PROFESSIONAL LAND SURVEYOR


1-18-19 DATE

-TIE SKETCH

NOTE: THE CORNER FALLS 1'± WEST OF THE CENTERLINE OF 7TH AVE AND 34'± NORTH OF THE CENTERLINE OF BEAVER AVE.



- SET 3/4" x 18" IRON REBAR, 1.50#/FT
- FOUND 3/4" IRON ROD
- FOUND 1-1/4" O.D. IRON PIPE
- FOUND HARRISON MONUMENT
- STEEL FENCE POST
- VINYL "T" POST

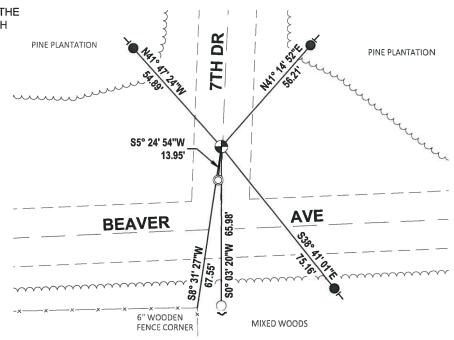

Government Land Corner Certificate		CODIUM	.o. 32
Adams County		CORNER N	vo
TYPE OF MONUMENT: Harrison		0_011011	19
CTATE DI ANIC COODDINIATED - NI		TOWN	
·		RANGE	_6
ELEVATION — M.S.L. DATUM:	SET MAR	<u> </u>	·;
	4100120		
FIELD BOOK: 83 PAGE 63 DRAWN BY: G. Rhinehort	.,		
DIMWIN DI: St. W. S.		 	+- N
BASIS FOR MONUMENT LOCATION		ļļ	
Show info such as: History of corner, with reference to Vol. and pg., dates, surveyor; exact description of monument		LOCATION	.i
replaced; if location computed, by taped or EDM traverse; landowner remarks, etc. (Use reverse side if necessary)	O.E.	(Indicated by 1	
	SE	} L: 	îte.
Set corner equidistant on line between adjacent	_	GREGOR' RHINEHA S-1478 Wisconsin F Wis.	VS. 111
	urvey	Salah All	- 1 1/4 1/4 1/4 1/4 1/4 1/4 1/4 1/4 1/4 1
to the east by Perry - Carrington, Inc.		GREGOR'	
, , , , , , , , , , , , , , , , , , , ,	***	RHINEHA S-1478	3 1 5
		Wisconsin F Wis.	Rapids
Excavation with backhoe yielded no evidence	€ €		
of any previous monumentation.		A NO SU	Rapids RAPID
		**************************************	999999
	D/	ATA SHOWN HERE	
		RTIFIED CORRECT:	~
	عديد	Hegory &	Rhenehaus
	Re	gistered Land Surveyor	~ ~~
	DA	ATE:	- 20-80
77	<u> </u>		
TIE SKETCH	Drive	GONE	
Show at least four ties, also fence lines, roads, topo, size and type of witness trees' and if off road - best way to	ASK 10	ACK-OAK/8T	
arrive at corner. Select IN 3" BUK DAK		~ . <-0NG	-
6 Jock America	1 8	14" Black	Dak.
GONE	8	NEW 81/	
CONC.	1 2 25	WHITE	E PINE W WIZH
CENTER OF	16. 98.2	0° n anc 2 .	a. KIGH
STREET SIGN Sego	1	4.00'	
- Bong		7,00	
33 '±	1"1.P.	& Beave	<u>.</u>
1	1. da 1. 1. 1. 1. 1. 1. 1. 1. 1. 1. 1. 1. 1.	Aven	ue
	EM 18		
6 WOODEN X			
FENCE COR	10"NORWA	Y (3) =	A 4
X	TCI	C Stack	Oak 18T
8 Stack Light X			
X \			

MAINTENANCE RECORD

DATE	BY WHOM	REMARKS
3-10-83	GR- SS	I NEW TIE
<i>z- -8</i> 8	6R - SS	OK
1-5-93	JG . B5	3-GONE, 2-NEW TIES
2-12-98	56	1-GONE, OK
1-28-03	IG 56-55	3-GONE, I-NEW, MON. OK. 3-GONE, 3-NEW, MON. OK
11-14-07	56-55	3-6 ONE 3-NEW, MON. OK
	•	·
-		