SECTION

DE ADAMS COUNTY

COUNTY CORNER NO: 40

ROMPORTOL ID: 41905122000


PUBLIC LAND SURVEY MONUMENT RECORD

HARRISON TYPE OF MONUMENT: ADAMS COUNTY COORDINATES, NAD 83 (2007) N. **279605.653** E. 525535.284 **ELEVATION-**DATUM — — FIELD WORK DATE: 01/17/2018


BASIS FOR MONUMENT LOCATION

1976 - PLS 1103 RAN AN EDM/TRANSIT TRAVERSE AROUND SECTION 7 AND THE ADJACENT SECTIONS TO DETERMINE THE SEARCH AREAS FOR INVESTIGATION, EXCAVATION WITH A BACKHOE YIELDED NO EVIDENCE OF THE ORIGINAL CORNER OR ANY REMONUMENTATION. CALCULATED THE CORNER LOCATION ON A LINE BETWEEN THE ADJACENT SECTION CORNERS AND PROPORTIONAL TO THE ORIGINAL NOTES. SET A HARRISON MONUMENT AT THE CORNER LOCATION AND TIED OUT.

2018 - PLS 2994 FOUND A HARRISON MONUMENT 18" BELOW THE SURFACE AND 1 IRON PIPE OF UNKNOWN ORIGIN. FOUND NO EVIDENCE OF ANY WITNESSES. ACCEPTED THE HARRISON MONUMENT AS THE BEST EVIDENCE OF THE CORNER LOCATION. SET 3 NEW TIES AND MEASURED TO THE TIES.

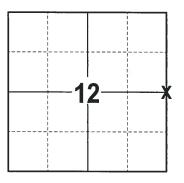

LOCATION (INDICATE CORNER BY "X")

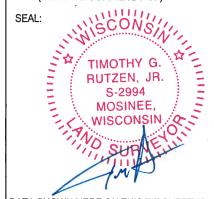

DATA SHOWN HERE ON THIS TIE SHEET IS CORRECT AND COMPLETE TO THE BEST OF MY KNOWLEDGE AND BELIEF.


PROFESSIONAL LAND SURVEYOR

3-1-18 DATE

- TIE SKETCH

NOTE: THE CORNER FALLS 10'± WEST OF THE CENTERLINE OF 14TH AVE AND 3'± NORTH OF THE CEMTERLINE OF THE FIRE LANE.



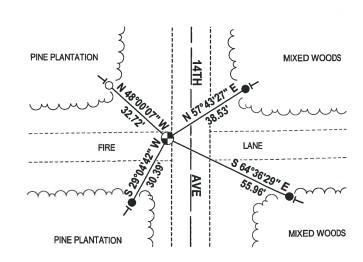

- 3/4" x 18" IRON REBAR SET, 1.50#/FT
- 4" O.D. IRON PIPE FOUND
- HARRISON FOUND → VINYL "T" POST

CORNER NO. ADAMS COUNTY SECTION Survey Monument Record 19 TOWN TYPE OF MONUMENT: Harrison 6 RANGE STATE PLANE COORDINATES: N_ ELEVATION - M.S.L. DATUM: _ THETA ANGLE: FIELD BOOK: FILE PAGE . BASIS FOR MONUMENT LOCATION (Use reverse side if necessary) LOCATION Show info such as: History of corner, with reference to Vol. (Indicated by 'X') and pg, dates, surveyor; exact description of monument replaced; if location computed, by taped or EDM traverse; landowner SEAL: Ran EDM/transit traverse around Section 7 and the adjacent sections to determine the search areas for investigation. DALE C. HAGEN Excavation with backhoe yielded no evidence of the S-1103 ✡ original corner or any remonumentation. Wisconsin Rapids Set corner on line between the adjacent section corners and proportional to the original notes. RN-DA-11-27-78 OK 6R-55 TIES 3-29-83 CERTIFIED CORRECT: 6R-55 OK 2-1-88 Q-GONE, Q-NEW TIES 1-6-93-JG-BS Registered Land Su DATE: Januar 1976 OK, 2-11-98-JG DATE: TIE SKETCH OK 12-30-02-JGPR (Show at least four ties) NOTE: Ties in trees to nail in disc. NOTE: NOTHING Ties in trees to nail in disc. AVAILABLE